

UNITED STATES PLYWOOD CORPORATION

P. O. BOX 1328 • ROSEBURG, OREGON • PHONE OR 2-3331



MANUFACTURERS OF WELDWOOD
PLYWOOD AND ALLIED PRODUCTS

1/4 Section Corner: Sections 26 and 35, T27S, R2W

Found: 3/4" Iron Rod

This rod was set by me in 1956 from the original bearing trees; subsequent logging destroyed all original bearing trees. I now set a 2 1/2" aluminum cap in place of the iron rod and reference to new bearing trees.

Set: 2 1/2" Aluminum Cap

15" Yew, South 45° West, 5.8 feet


Marked: 1/4 S35 BT

13" Yew, North 75 1/2° E, 47.4 feet

Marked: 1/4 S26 BT

December 1962

✓ + O

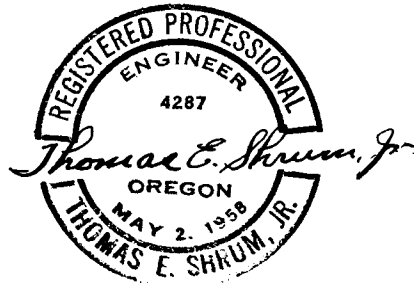

FILED
RECEIVED

APR 10 1963

COUNTY SURVEYOR
DOUGLAS COUNTY, ORE.

C. S. File No. 51/254-9