

UNITED STATES PLYWOOD CORPORATION

P. O. BOX 1328 • ROSEBURG, OREGON • PHONE OR 2-3331



Section Corner: Sections 27, 28, 33, 34 T27S, R2W

Found: 1½ Iron Pipe

30" Cedar stump, South 21° East, 25.7 feet

Rescribed: S34 BT

34" Douglas fir stump, South 21½° West, 11.9 feet

Rescribed: S33 BT

30" Cedar stump, North 11½° West, 7.9 feet

Rescribed: S28 BT

36" Hemlock stump, North 57½° East, 42.2 feet


Set: 2½ Aluminum Cap

35" Cedar stump, North 17½° East, 50.5 feet

Marked: S27 BT

December 1962

+ O

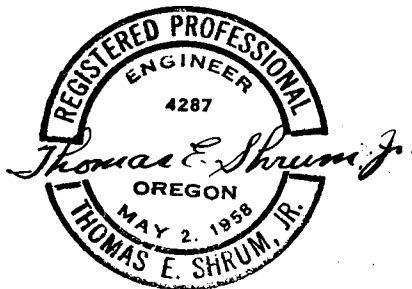

FILED
RECEIVED

APR 10 1963

COUNTY SURVEYOR
DOUGLAS COUNTY, ORE.

C. S. File No. 51/254-30