

UNITED STATES PLYWOOD CORPORATION

P. O. BOX 1328 • ROSEBURG, OREGON • PHONE OR 2-3331



MANUFACTURERS OF WELDWOOD
PLYWOOD AND ALLIED PRODUCTS

Section Corner: Sections 25, 26, 35, 36 T27S, R2W

Found:


- 26" Douglas fir stump, South 49° West, 5.6 feet
Scribe good condition (Original, 24" Douglas fir)
- 36" Douglas fir stump, North 55° West, 20.0 feet
Rescribe: S26 BT (Original, 30" Douglas fir)
- 18" Yew, South 65½ East, 26.7 feet
Rescribe: S36 BT

Set: 2½" Aluminum Cap

- 22" Douglas fir stump, North 15½° East, 12.1 feet
Marked: S25 BT
(Original Hemlock for S25 is gone.)

December 1962

✓ + On

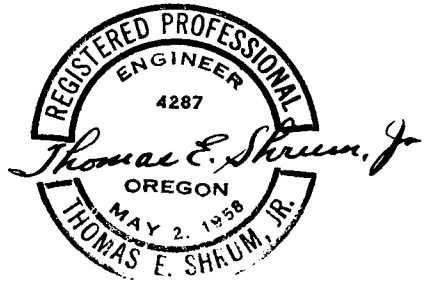

FILED
RECEIVED

APR 10 1963

COUNTY SURVEYOR
DOUGLAS COUNTY, ORE.

C. S. File No. 51/254-11