

**UNITED STATES PLYWOOD CORPORATION**

P. O. BOX 1328 • ROSEBURG, OREGON • PHONE OR 2-3331



MANUFACTURERS OF WELDWOOD  
PLYWOOD AND ALLIED PRODUCTS

Section Corner: Sections 1, 2, 11, 12 T25S, R1W


Found:

- 12" Douglas fir, South 12° East, 21.1 feet
- 11" Yew, North 04° East, 49.0 feet (down)

Set: 2½" Aluminum Cap

- 62" Douglas fir stump, North 25½° East, 29.2 feet  
Marked S1 BT
- 64" Douglas fir, North 46° West, 69.3 feet  
Marked S2 BT
- 5" Vine Maple, South 81½° West, 6.4 feet  
Marked S11 BT

January 1963

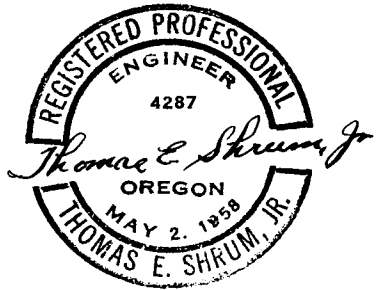

FILED  
RECEIVED

APR 10 1963

COUNTY SURVEYOR  
DOUGLAS COUNTY, ORE.

V+O