

UNITED STATES PLYWOOD CORPORATION

P. O. BOX 1328 • ROSEBURG, OREGON • PHONE OR 2-3331



MANUFACTURERS OF WELDWOOD
PLYWOOD AND ALLIED PRODUCTS

Section Corner: Sections 26, 27, 34, 35 T27S, R3W

Found:



- 26" Cedar (dead) North 16° West, 22⁵/₁₆ feet
4" x 6" Aluminum reference tag
- 21" Douglas fir stump, South 39° West, 41⁰/₁₆ feet
4" x 6" Aluminum reference tag

The 4" x 6" Aluminum reference tags were set by me in October 1957 from the original bearings trees. Subsequent logging destroyed the original bearing trees and the stake set on the corner. From the reference tags, I reset the corner and scribe new bearing trees.

Set: 2-1/2 Aluminum Cap

- 10" Yew, South 85° West, 64⁰/₁₆ feet
Marked: S34 BT RE 4287
- 14" Cedar, South 34° East, 88⁶/₁₆ feet
Marked: S35 BT RE 4287
- 12" Yew, North 45° West, 83²/₁₆ feet
Marked: S27 BT RE 4287
- 36" Cedar stump, North 75° East, 87⁰/₁₆ feet
Marked: S26 BT RE 4287

Bearing trees scribed January, 1961
2½ Aluminum Cap February, 1963

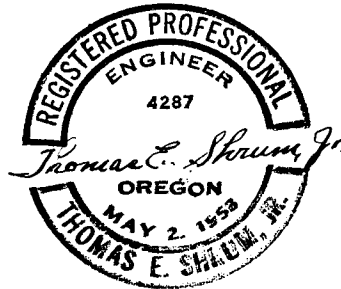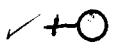

FILED
RECEIVED

APR 10 1963

COUNTY SURVEYOR
DOUGLAS COUNTY, ORE.

C. S. File No. 51/254-75