

UNITED STATES PLYWOOD CORPORATION

P. O. BOX 1328 • ROSEBURG, OREGON • PHONE OR 2-3331




MANUFACTURERS OF WELDWOOD
PLYWOOD AND ALLIED PRODUCTS

1/4 Section Corner: Sections 15 and 22, T25S, R1W
Found: 9" Cedar, North 21° East, 20.4 feet (poor condition)

Set: 2½ Aluminum Cap
16" Hemlock, North 73½° East, 36.0 feet
Marked: 1/4 S15 BT
9" Cedar, South 34° West, 7.2 feet
Marked: 1/4 S22 BT

February 1963

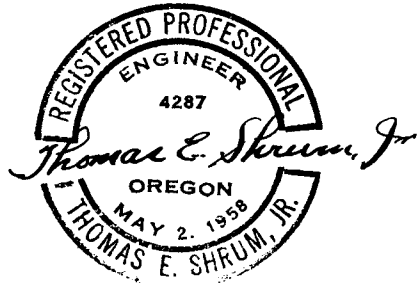

FILED
RECEIVED

APR 10 1963

COUNTY SURVEYOR
DOUGLAS COUNTY, ORE.

✓ TO

C. S. File No. 51/254-16