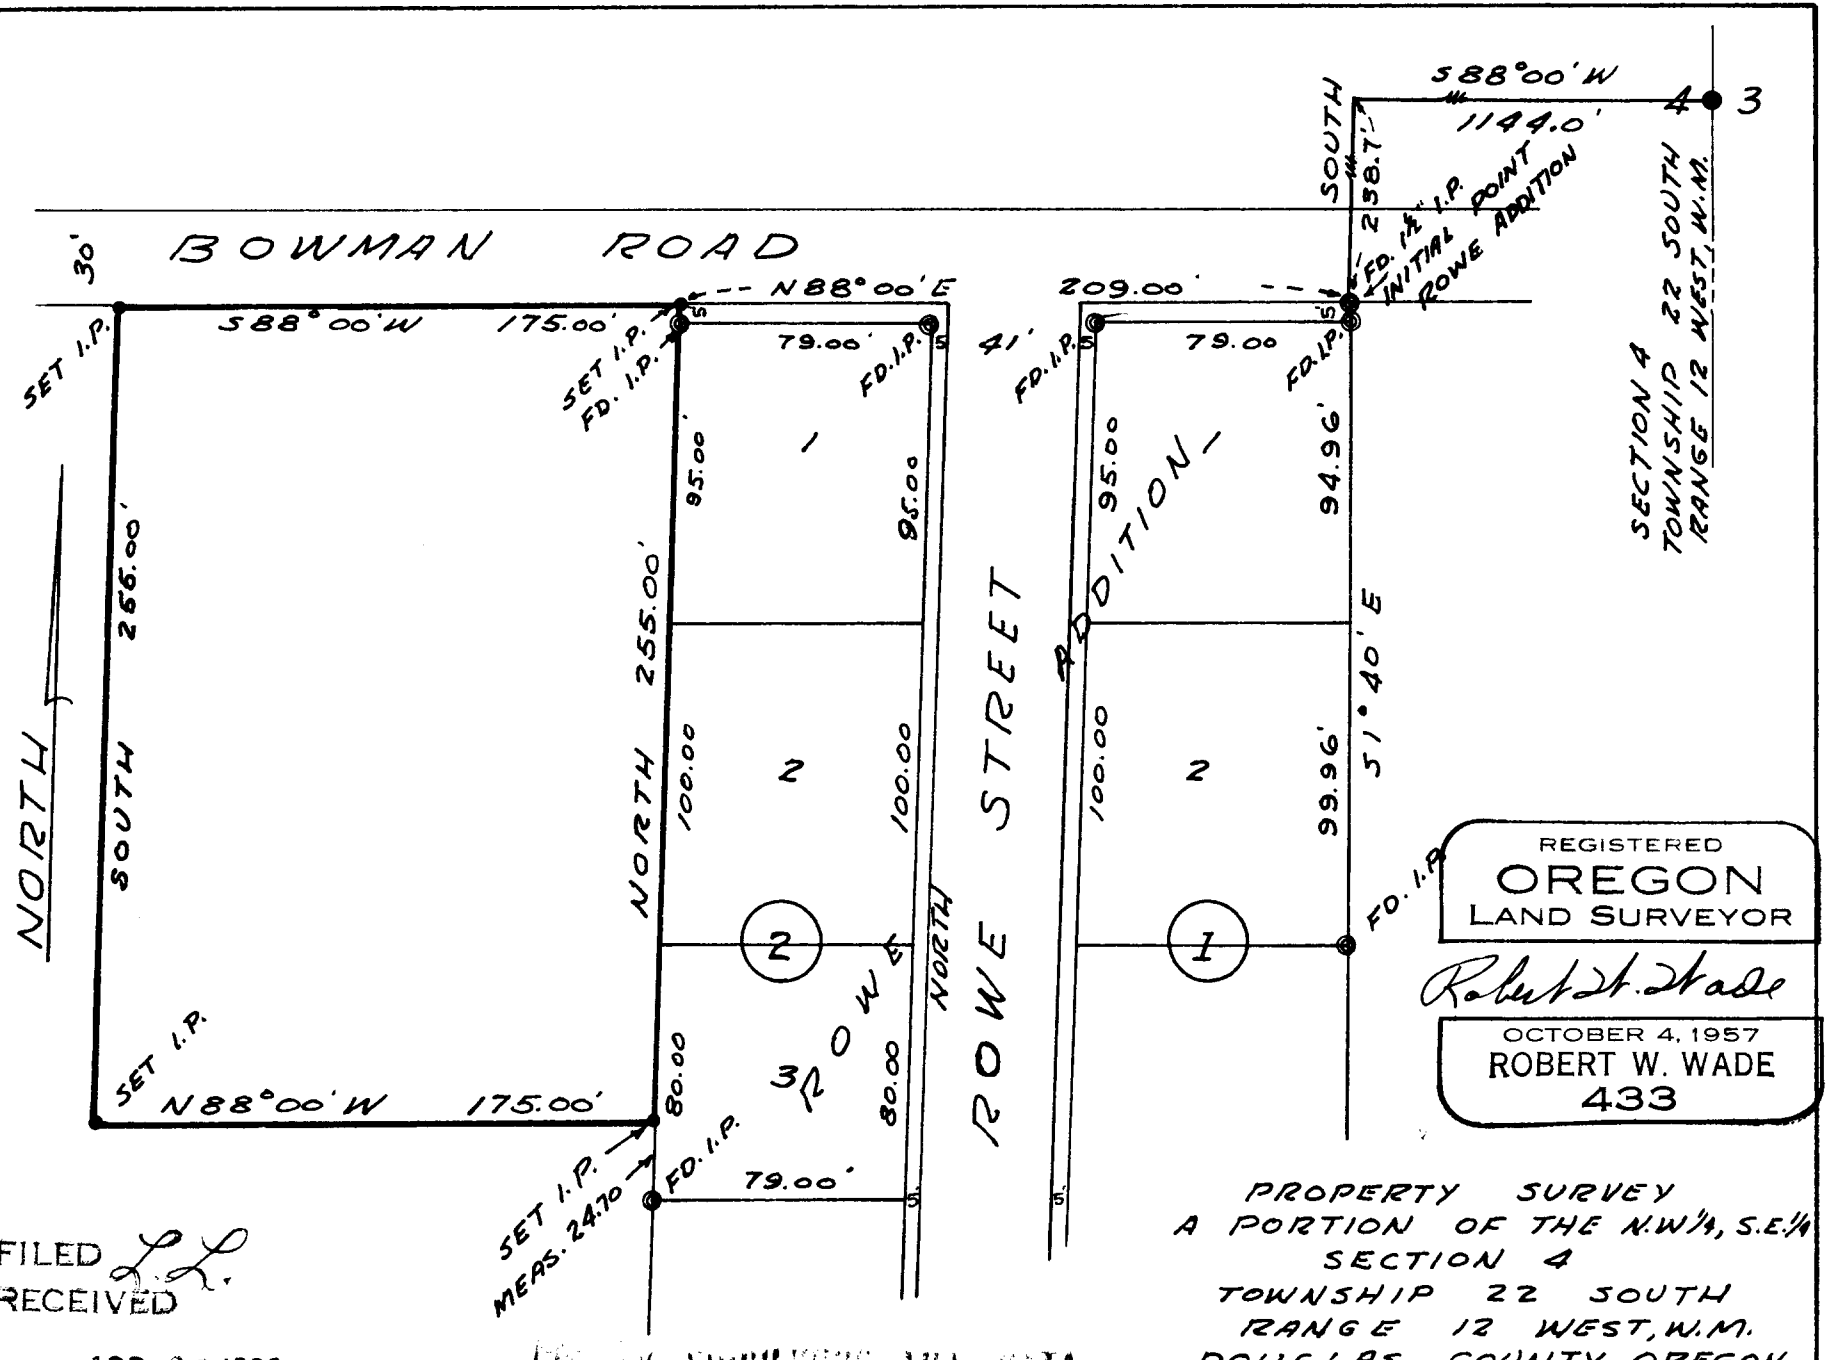

REGISTERED
OREGON
LAND SURVEYOR

Robert W. Wade

OCTOBER 4, 1957
ROBERT W. WADE
433

FILED
RECEIVED
APR 26 1963
COUNTY SURVEYOR
DOUGLAS COUNTY, ORE.

PROPERTY SURVEY
A PORTION OF THE N.W.¼, S.E.¼
SECTION 4
TOWNSHIP 22 SOUTH
RANGE 12 WEST, W.M.
DOUGLAS COUNTY, OREGON
FOR WILLIAM JAYNE
SCALE: 1" = 60' 3-5-60
R.H. ERICHSEN & ASSOCIATES
5TH & HIGHLAND, COOS BAY, OREGON

FIL. No. 31/256-1