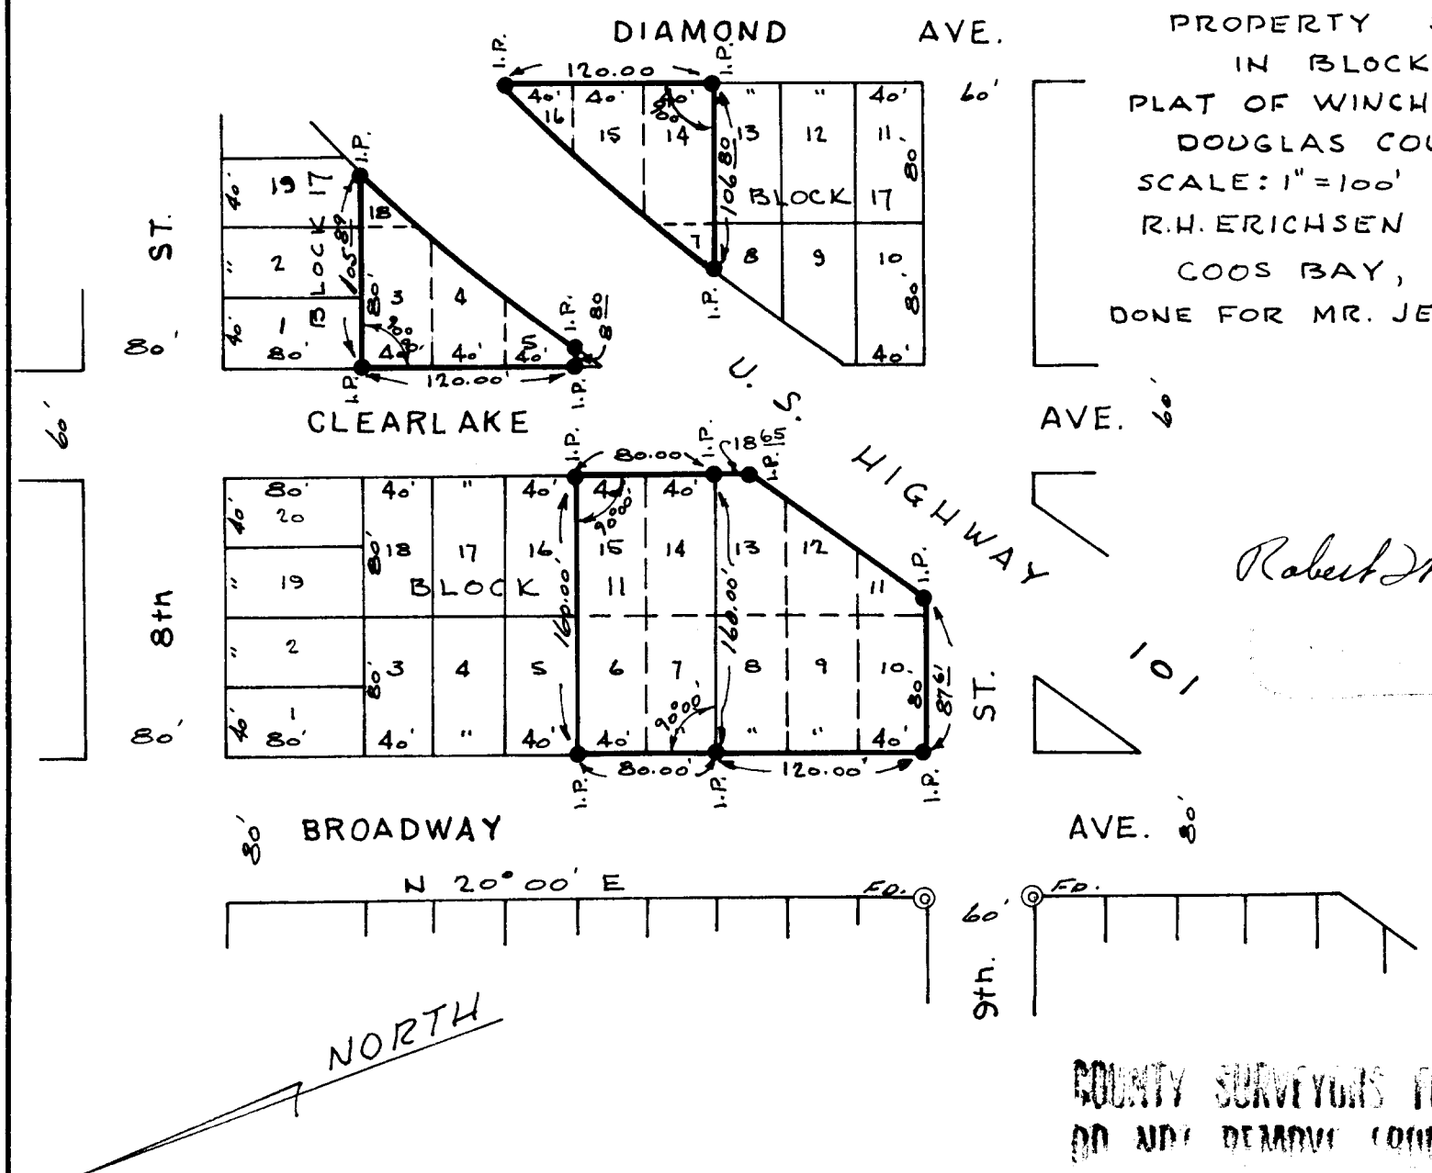

PROPERTY SURVEYS
IN BLOCKS 11 & 17
PLAT OF WINCHESTER BAY,
DOUGLAS COUNTY, OREGON
SCALE: 1" = 100' 11-4-63
R.H. ERICHSEN & ASSOCIATES
COOS BAY, OREGON
DONE FOR MR. JEFF LIGHTFOOT

Robert H. Hable

FILED
RECEIVED
JAN 2 1964
COUNTY SURVEYOR
DOUGLAS COUNTY, ORE.

COUNTY SURVEYORS FILE DATA
DO NOT REMOVE FROM OFFICE

51/25673