

RESTORED CORNER FOR STATE OF OREGON-DEPARTMENT OF FORESTRY

Section corner common to Sections 14, 15, 22 and 23,
T.22S, R.11W, W.M., Douglas County, Oregon.

ORIGINAL

Stone 20" x 20" x 10" (found in place, marked X, 3 notches South and
2 notches East) from which a:

- 12" Alder bears N51E 34 lks.; now missing.
- 10" Alder bears S8E 28 lks.; now missing.
- 10" Fir bears S31W 71 lks.; now rotted 3 ft. high stump, piece
of scribe cast remaining.
- 8" Fir bears N36W 26 lks.; now rotted 1 ft. high stump, portion
of scribe T remaining.

RESTORATION by 1941 Elliott Survey

Cedar Post (found, 4' x 4' x 48", on North side of corner stone) from
which a:

- 8" Alder bears N83E 6 lks.; found, now 12", overgrown.

RESTORED


- 36" Fir bears S36E 73.7 ft.; scribed T22S R11W S23 BT.
- 12" Alder bears N80E 4.0 ft.; scribed T22S R11W S14 BT.
- 19" Fir bears S88W 97.0 ft.; scribed T22S R11W S22 BT.
- 24" Fir bears N78W 99.0 ft.; scribed T22S R11W S15 BT RS 359.

Oregon State Forestry Department metal location poster on 28" Cedar West
62.6 ft.

Dated Nov. 14, 1963

Restored by

Present and witnessed by R. Schulson
T. South

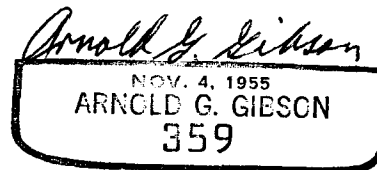

FILED
RECEIVED

NOV 26 1963

COUNTY SURVEYOR
DOUGLAS COUNTY, ORE.

⊕ ✓
#51

C. S. File No. 51/260-5