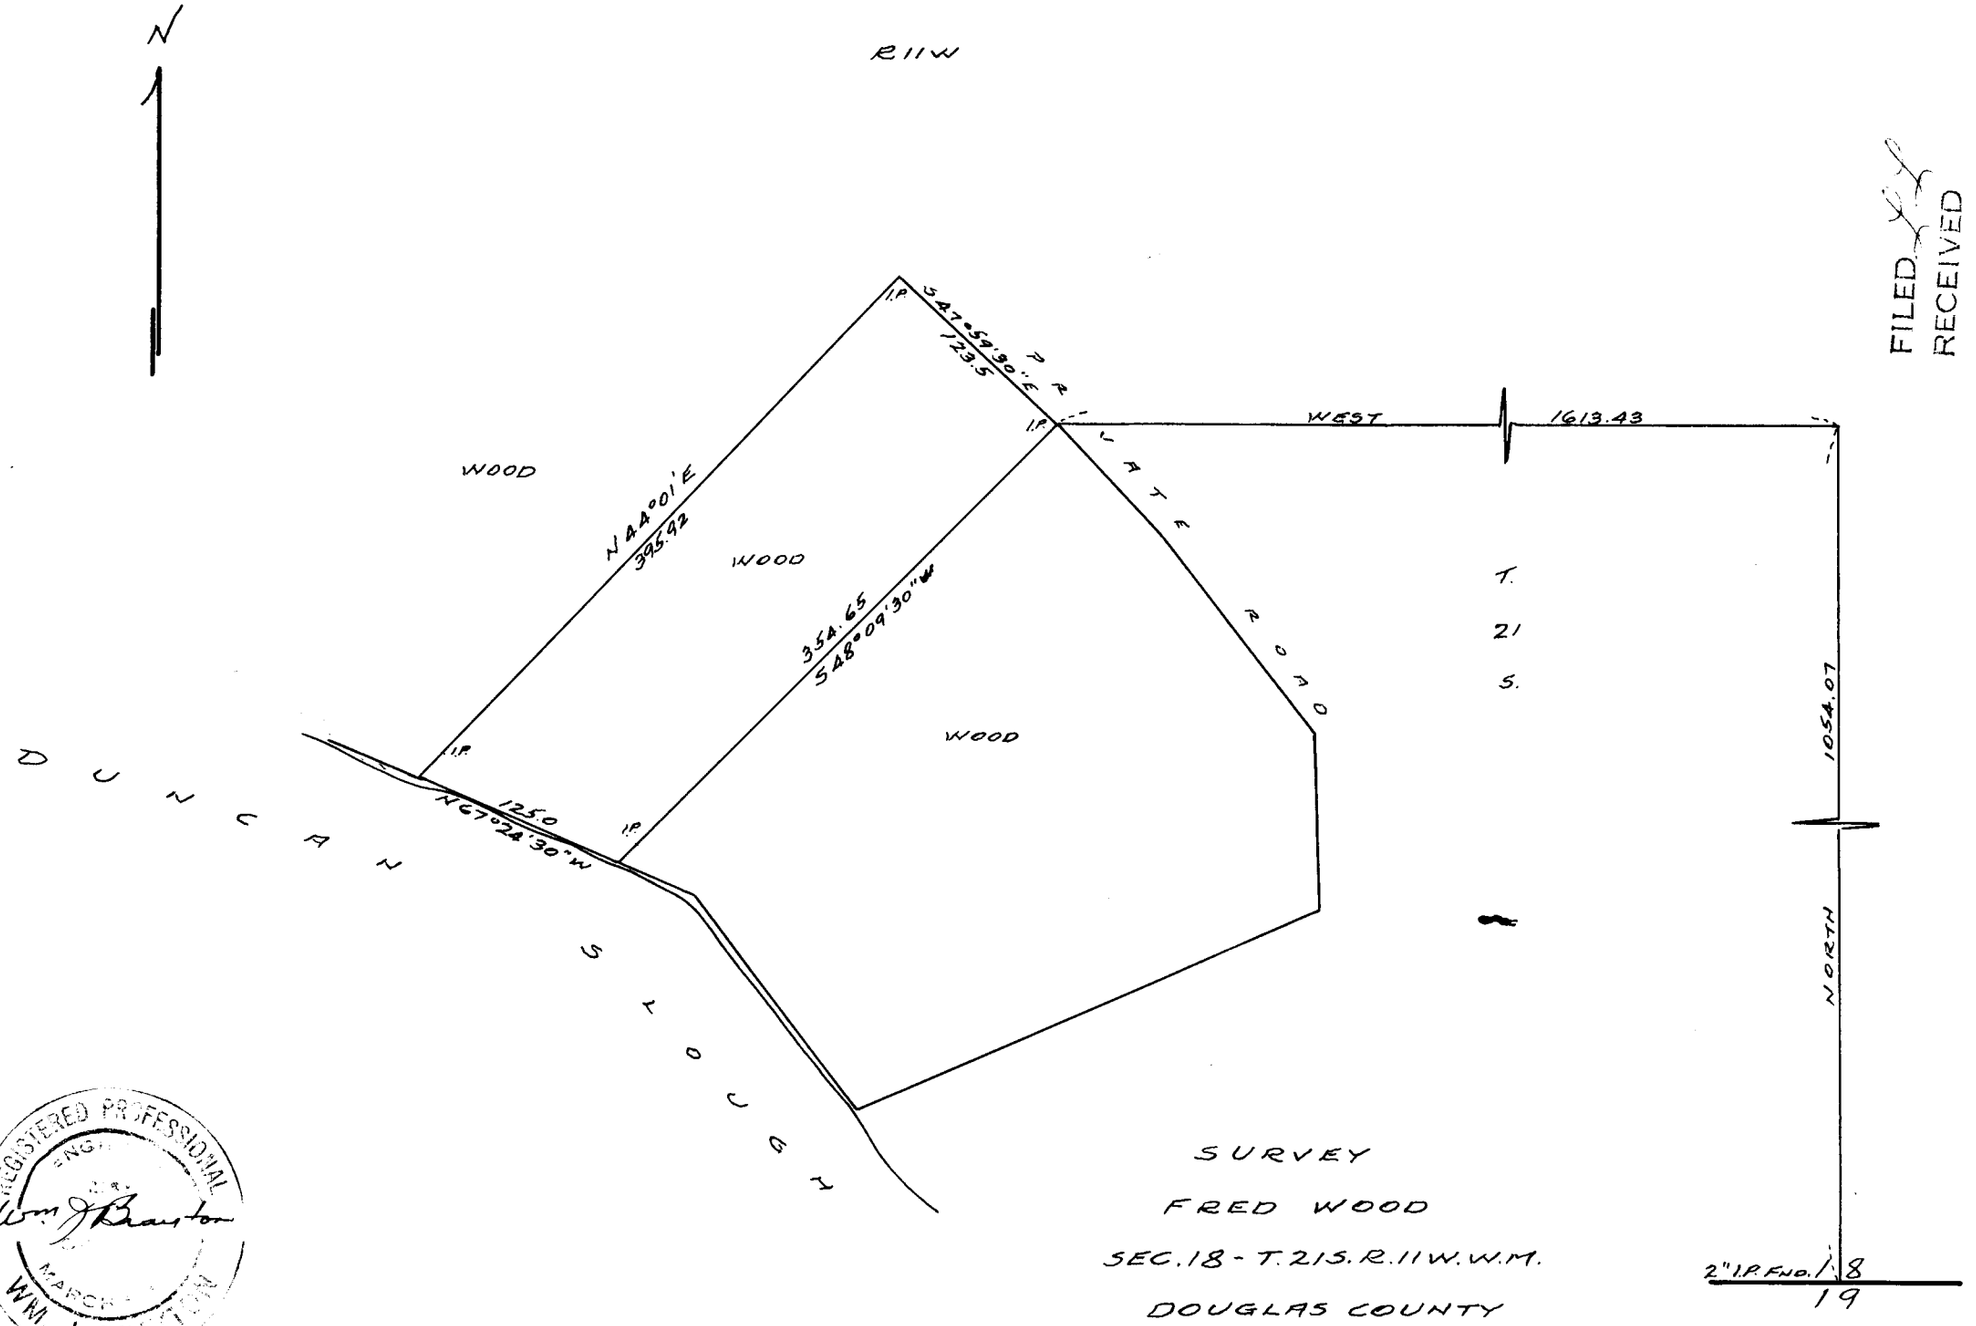

SURVEY
FRED WOOD
SEC. 18 - T. 21 S. R. 11 W. W.M.
DOUGLAS COUNTY
Scale 1" = 100'. Aug. 1963.

REGISTERED PROFESSIONAL ENGINEER
Wm J Brantom
MARCH
WM. J. BRANTOM

FILED
RECEIVED
OCT 4 1963
COUNTY SURVEYOR
DOUGLAS COUNTY, ORE.

P File No. 51/26Z-1