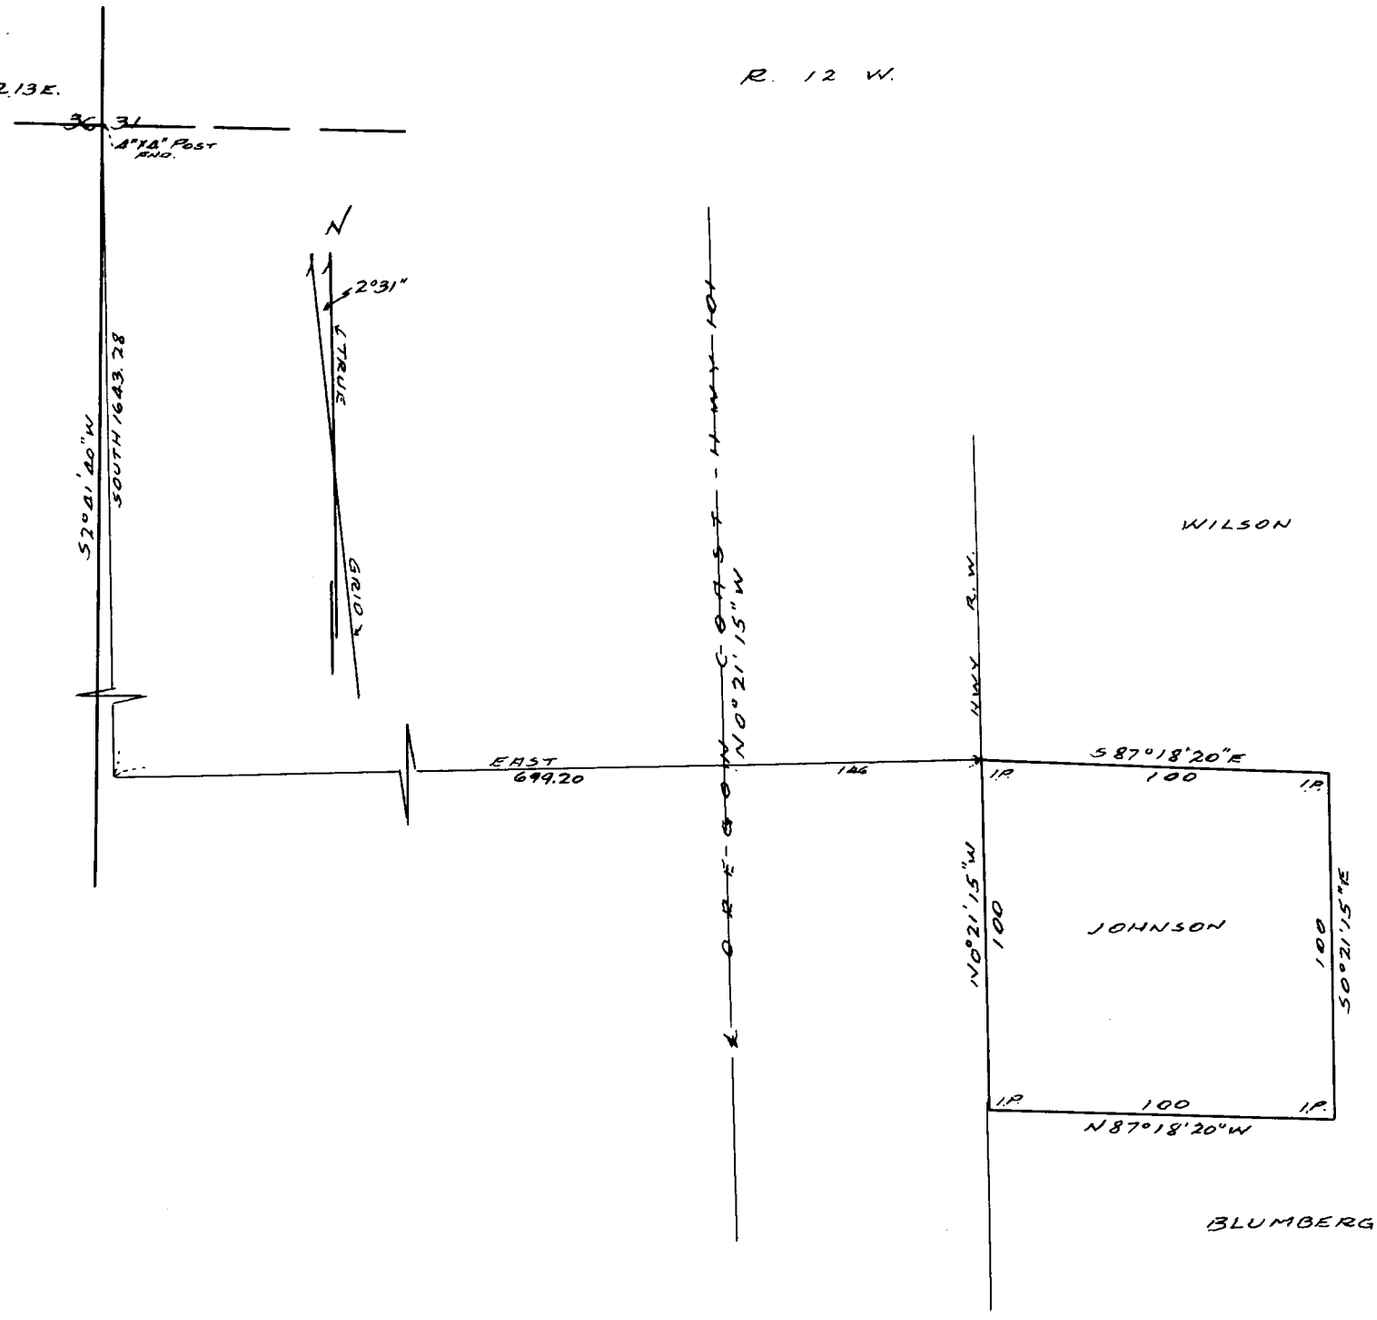

SURVEY

RUDY JOHNSON

SEC. 31 - T. 22S, R. 12 W. W. M.

DOUGLAS COUNTY

Scale 1" = 50' AUG. 1963.

BEARINGS & CO-ORDINATES FRO
O.S.H. DWG. 78-11-7.

REGISTERED PROFESSIONAL ENGINEER
WM. J. ERAYTON

FILED
RECEIVED

OCT 4 1963

COUNTY SURVEYOR
DOUGLAS COUNTY, ORE.

File No. 51/26