FILED
RECEIVED
APR 27 1964
COUNTY SURVEYOR
DOUGLAS COUNTY, ORE.

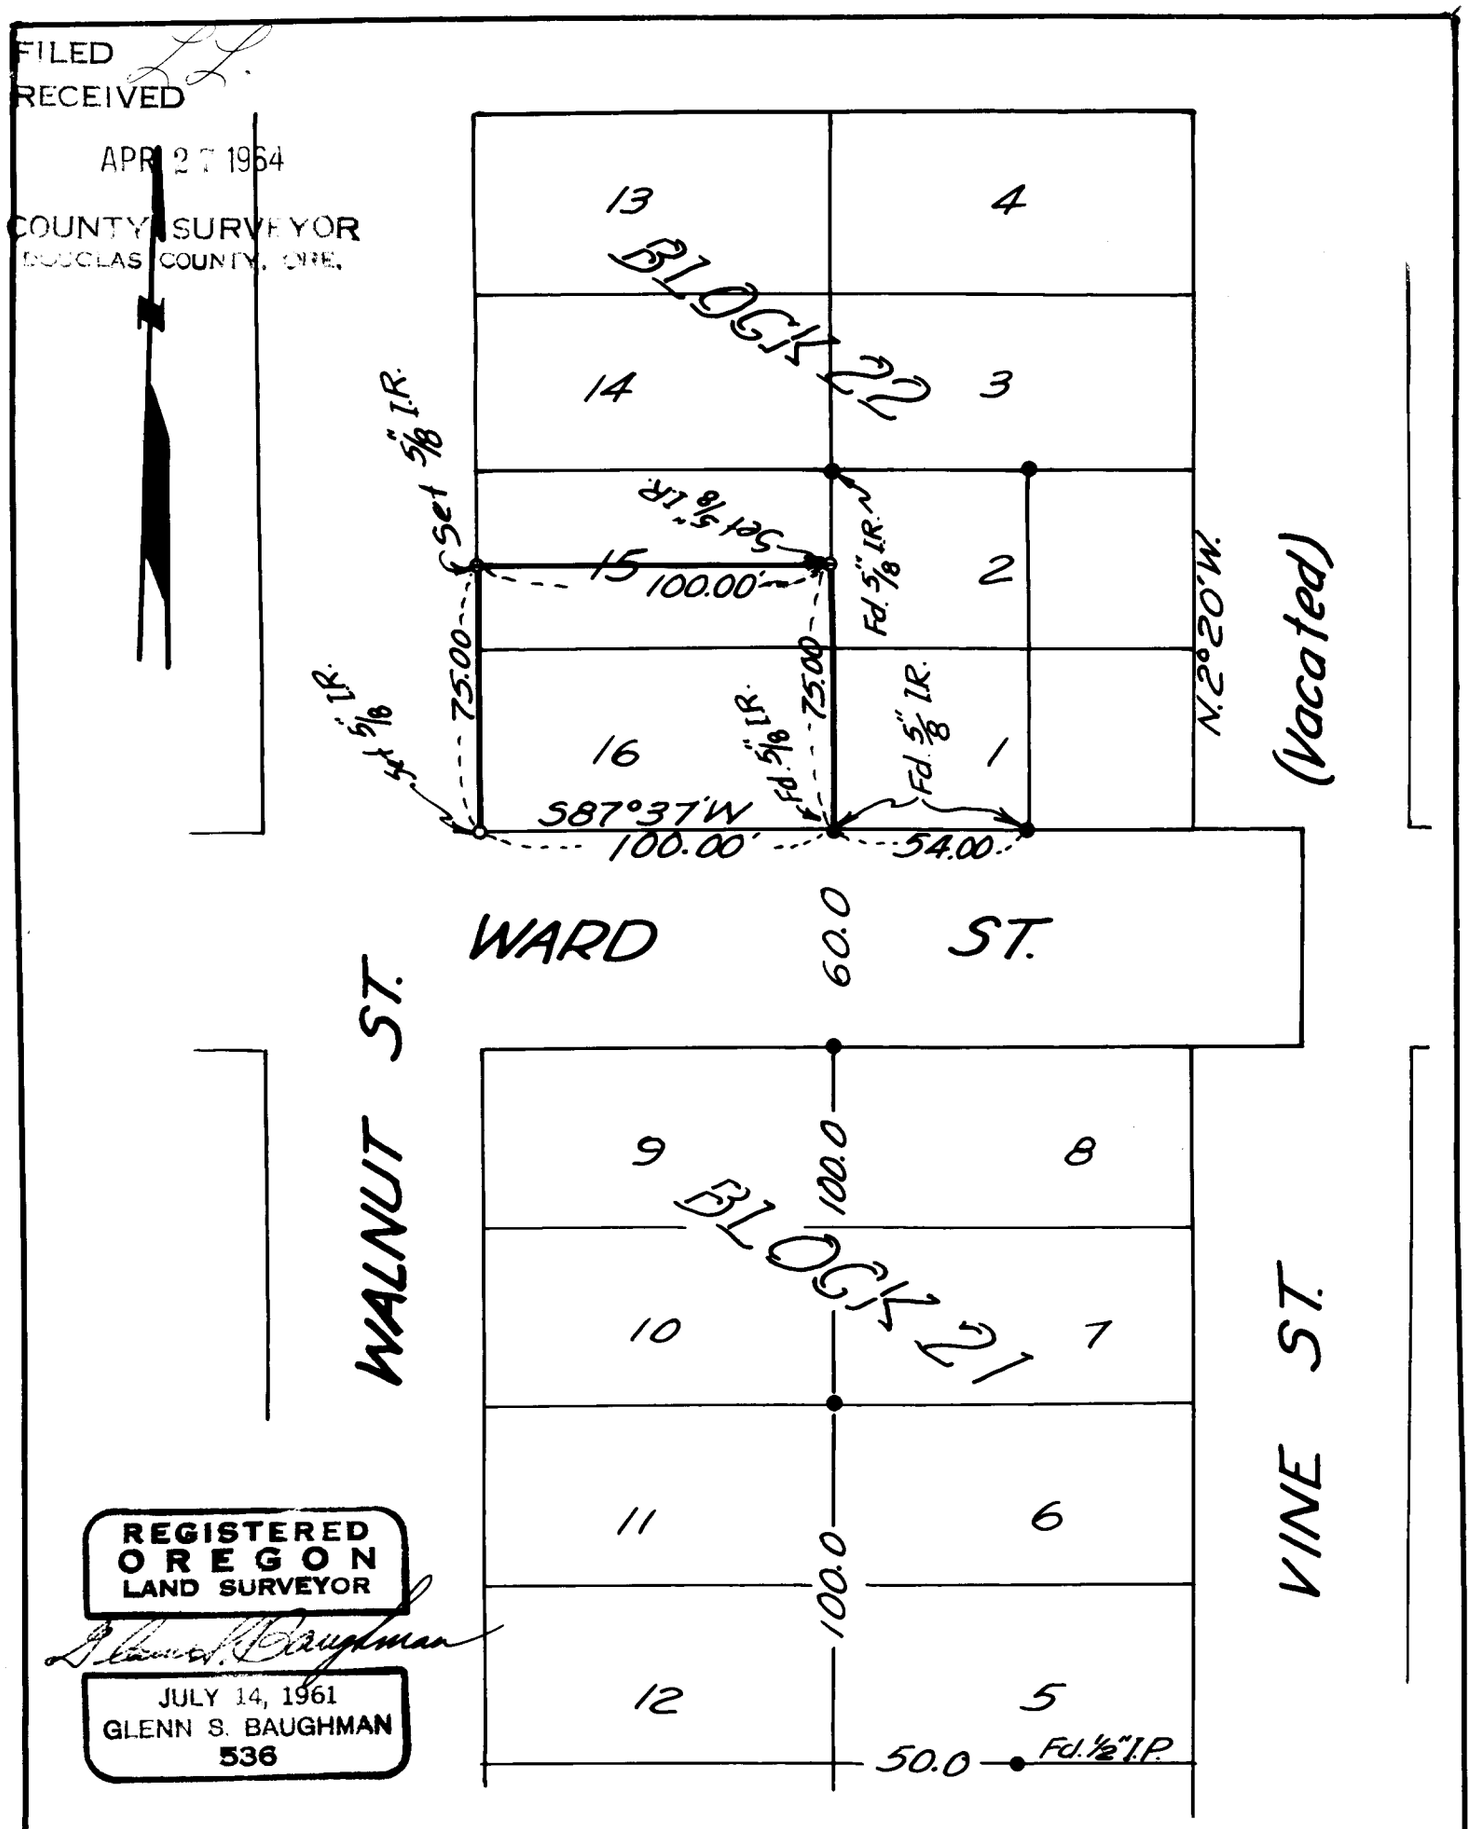

REGISTERED
OREGON
LAND SURVEYOR
Glenn S. Baughman
JULY 14, 1961
GLENN S. BAUGHMAN
536

SURVEY FOR PROPERTY DESCRIPTION
BLOCK 22 RIVERSIDE ADD.
FOR JAMES FLYNN

Apr. 20, 1964 Scale 1" = 50'

Note: Found monuments & used control C.S. File 51/271

COUNTY SURVEYORS FILE DATA
DO NOT REMOVE FROM OFFICE

C.S. File No. 51/271-4