WEST 55 ft. LOT 19 - OAK KNOLL SUBDIVISION

DOUGLAS COUNTY
OREGON

T. 27-6 [illegible]

C.B. Ashby

COUNTY SURVEYOR FILE DATA
DO NOT REMOVE FROM OFFICE

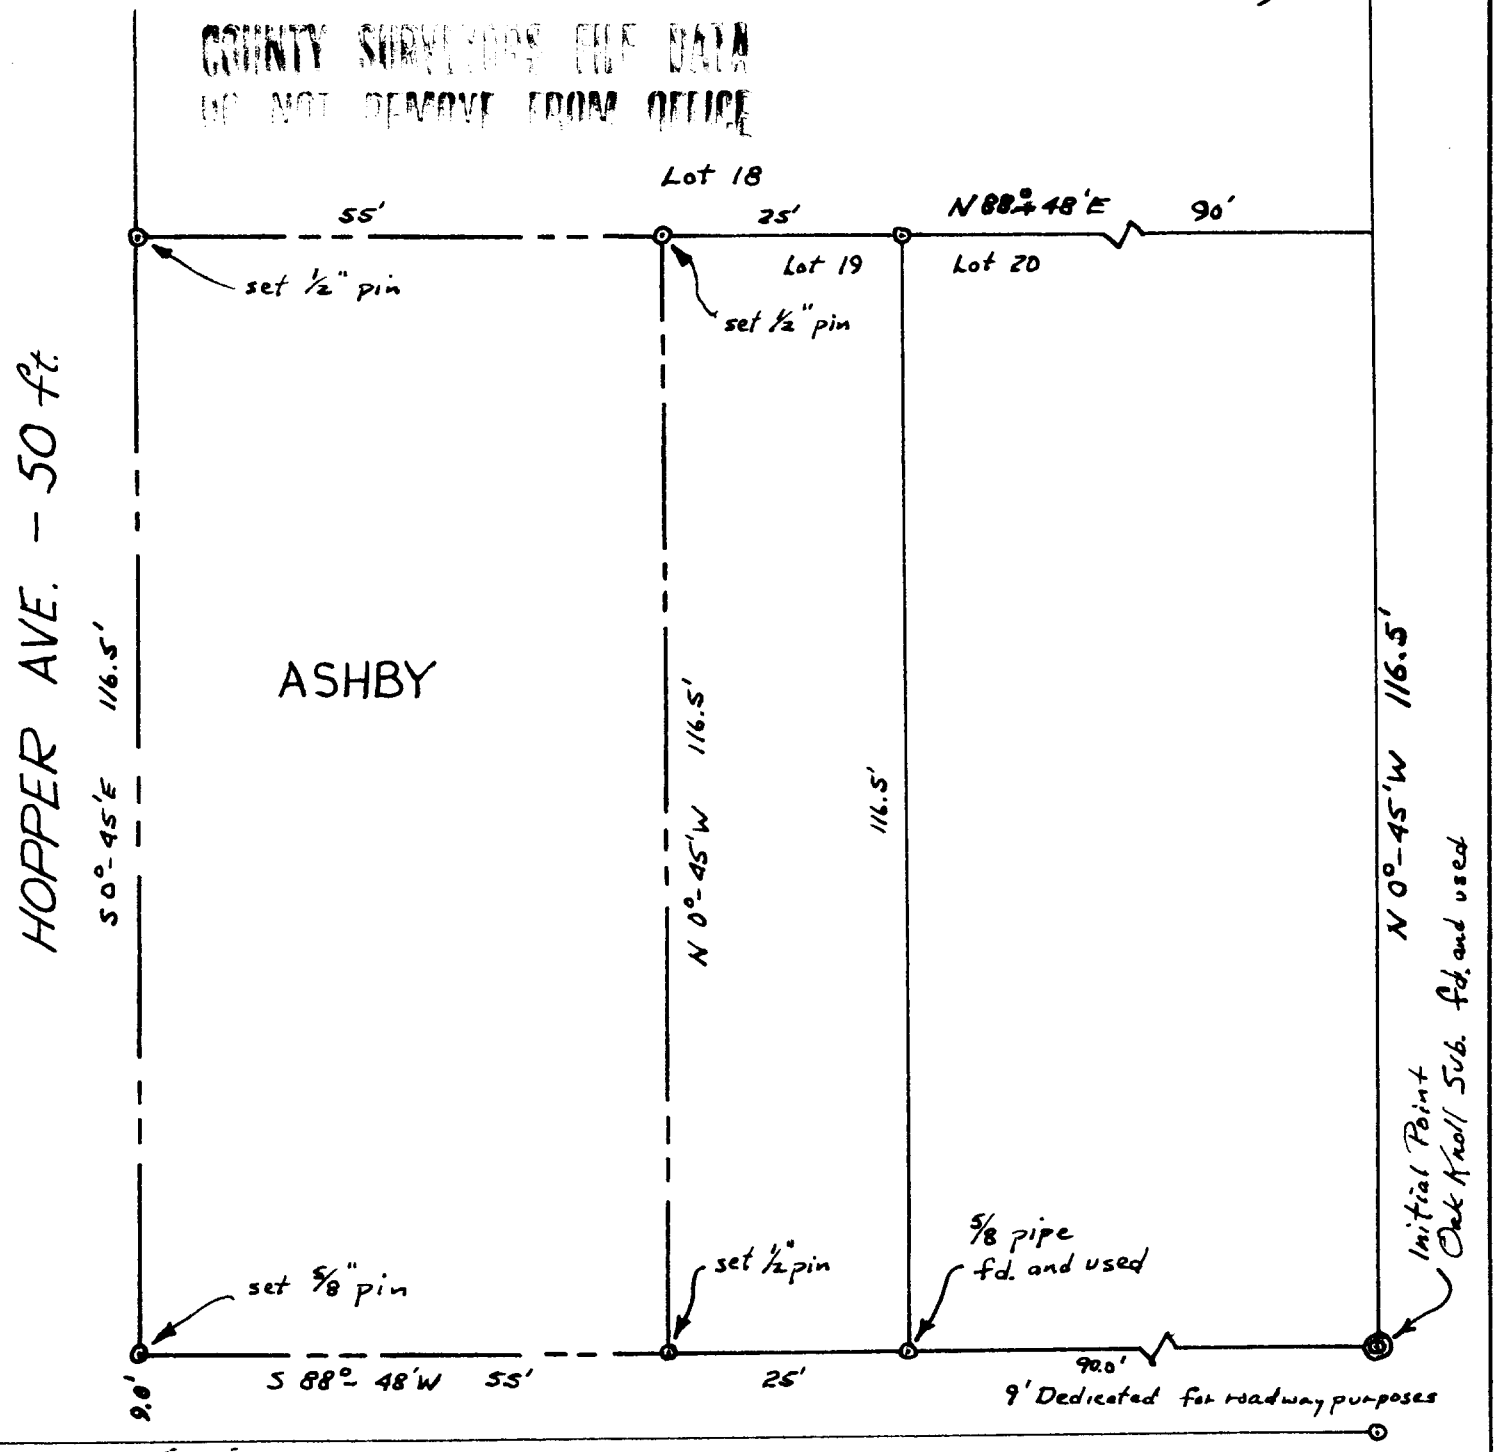

CALKINS RD. — 40 ft.

FILED
RECEIVED

MAY 26 1964

COUNTY SURVEYOR
DOUGLAS COUNTY, ORE.

Scale 1" = 20'

May 12, 1964

JAMES R. DAUGHERTY
[illegible] SANITARY ENGINEER
[illegible]TON, OREGON

REGISTERED PROFESSIONAL ENGINEER
James R. Daugherty
OREGON

BW

C.S. No. 51/274-53