FILED
RECEIVED

MAR 12 1965

COUNTY SURVEYOR
DOUGLAS COUNTY, ORE.

REGISTERED
OREGON
LAND SURVEYOR
Robert W. Wade
OCTOBER 4, 1957
ROBERT W. WADE
433

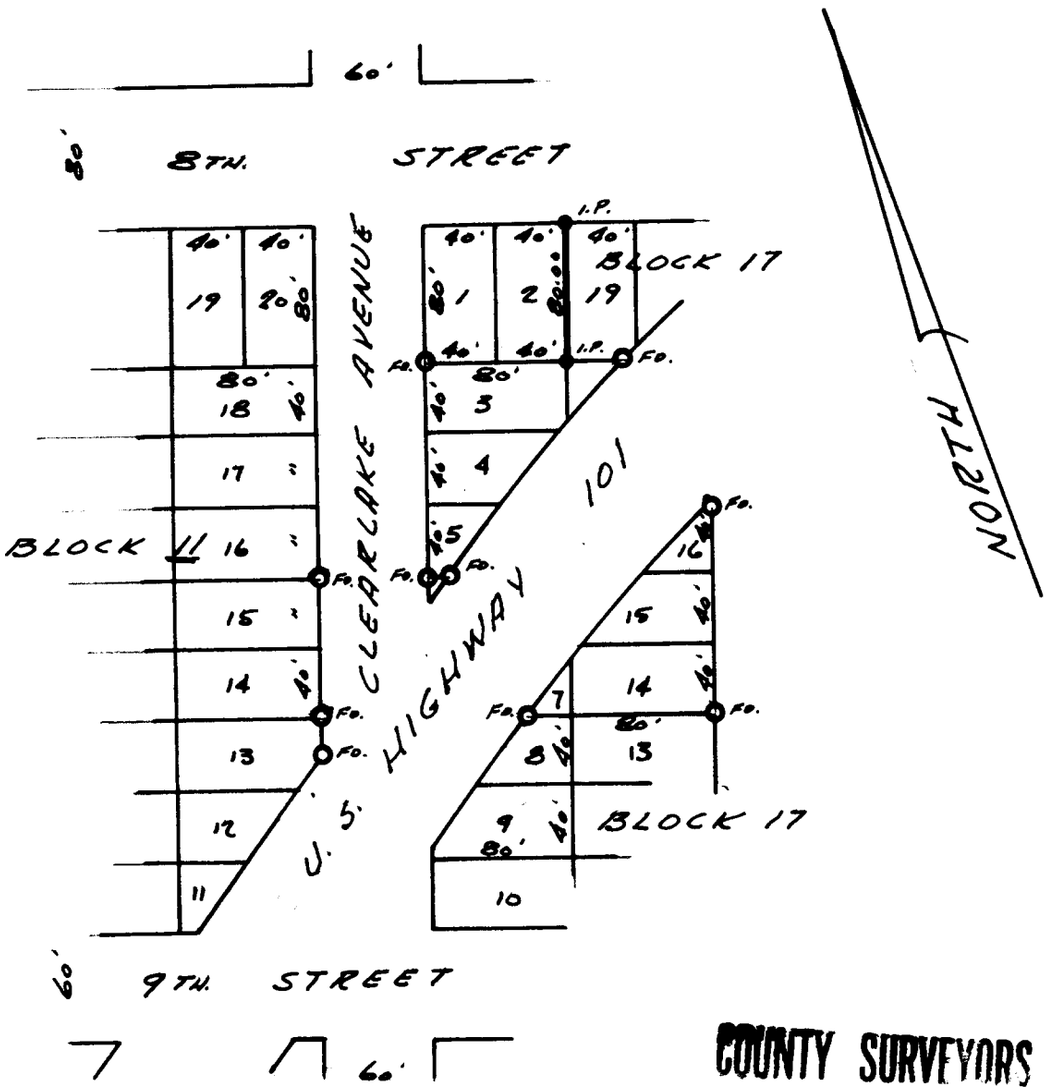

PROPERTY SURVEY
WEST LINE LOT 19, BLOCK 17
PLAT OF WINCHESTER BAY
DOUGLAS COUNTY, OREGON
FOR JEFF SHINN
SCALE: 1" = 100' 10-31-64
R.H. ERICHSEN & ASSOCIATES
COOS BAY, OREGON

COUNTY SURVEYORS FILE DATA
DO NOT REMOVE FROM OFFICE

T 22 S - R 12 W SEC. 7

C. S. File No. 51/272 #6