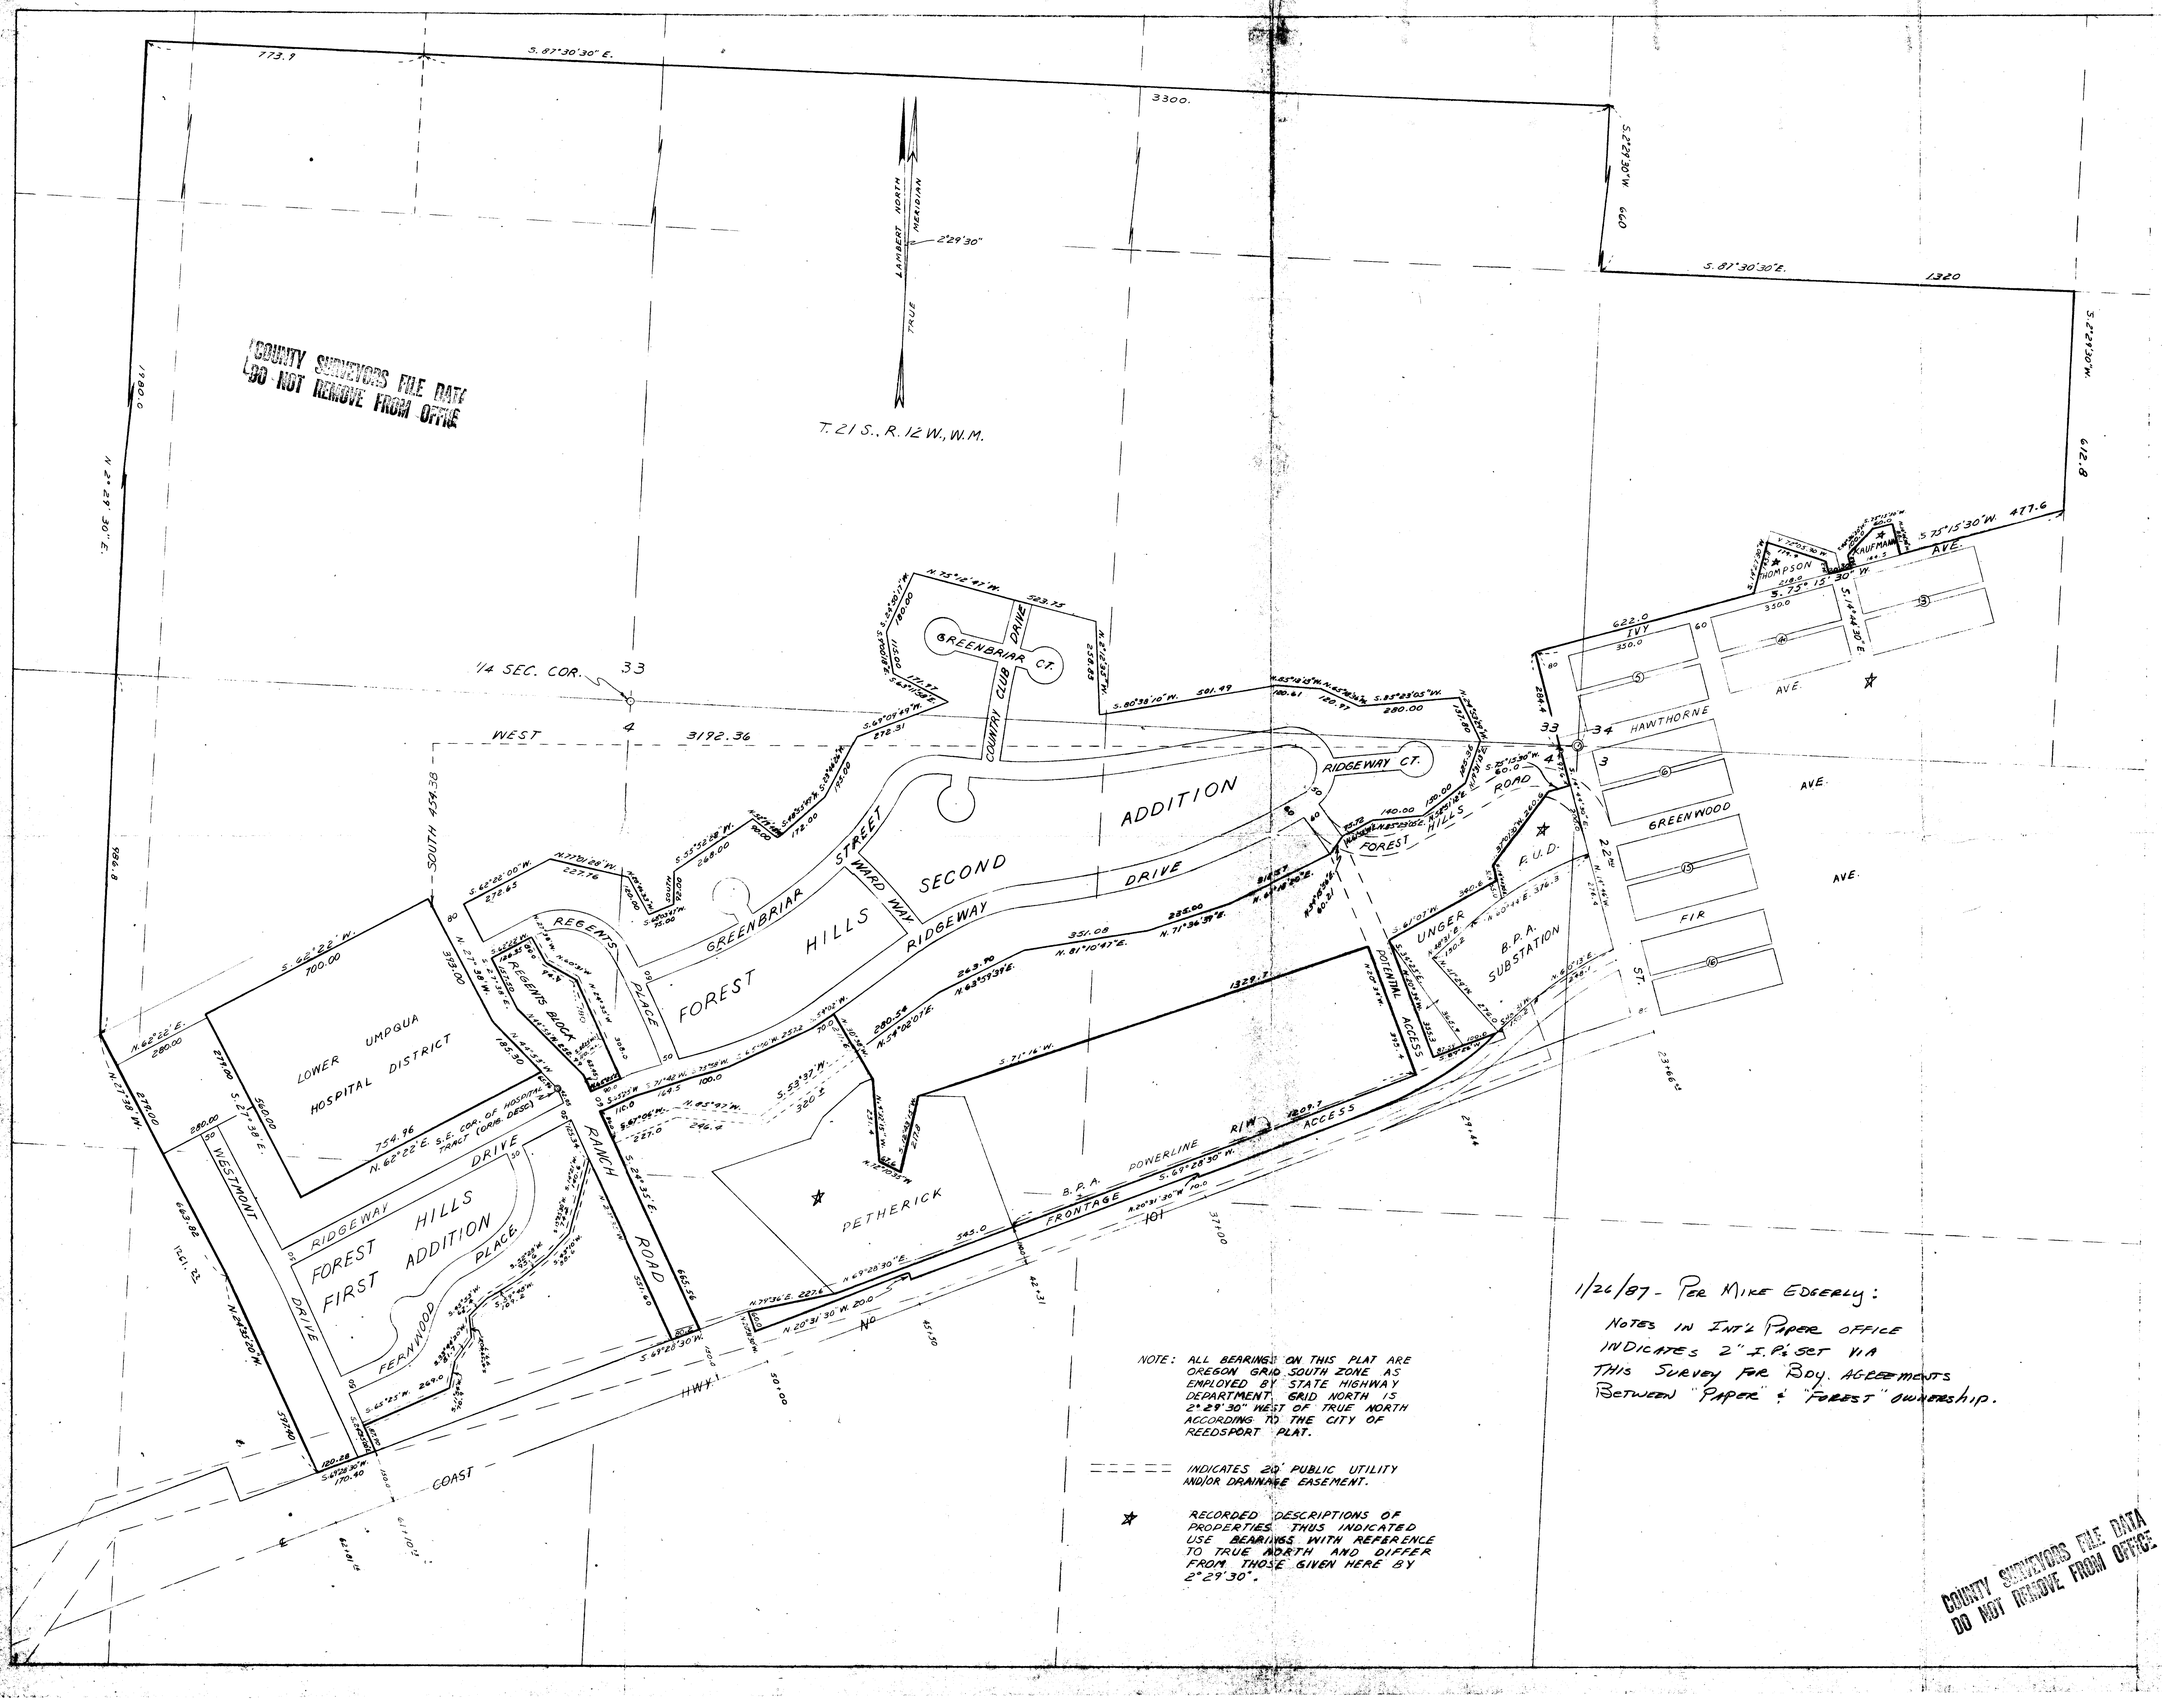

REF. DWGS.	
NO.	TITLE

REV. NO.	DATE	REVISIONS	DR. BY	CHKD. BY
"	"	FOREST HILLS ROAD R/W ADDED	NAN	
"	"	1st ADDITION BEARINGS & DISTANCES REVISED	NAN	
4	2-21-68	FOREST HILLS ADDED	NAN	
"	"	DISTANCES REVISED E. OF KAUFMANN PROPERTY	NAN	
3	7-18-63	PORTION OF BOUNDARY REVISED W. OF RANCH RD.	NAN	
2	5-20-63	UTILITY EASEMENT BEARINGS & DISTANCES ADDED	NAN	
1	5-17-63	THOMPSON EASEMENT ADDED	NAN	

INTERNATIONAL PAPER COMPANY
GARDINER PAPER MILL
GARDINER, OREGON

R. H. HUBBARD PROPERTY PLAT

DRAWN BY NAN	TRACED BY	DRAWING NO.
DATE 5-15-63	SCALE-1"=200FT.	

COUNTY SURVEYORS FILE DATA
DO NOT REMOVE FROM OFFICE