COUNTY SURVEYORS FILE DATA
DO NOT REMOVE FROM OFFICE

SURVEY FOR DEED DESCRIPTION
SECTION 14, T. 27 S., R. 6 W. W. M.

SURVEYED MAY 15, 1964 BY
JAMES W. BYRON SCALE: 1" = 50'
SURVEYED FOR — ED MOON

REGISTERED
OREGON
LAND SURVEYOR

James W. Byron

NOV. 6, 1953
JAMES W. BYRON
303

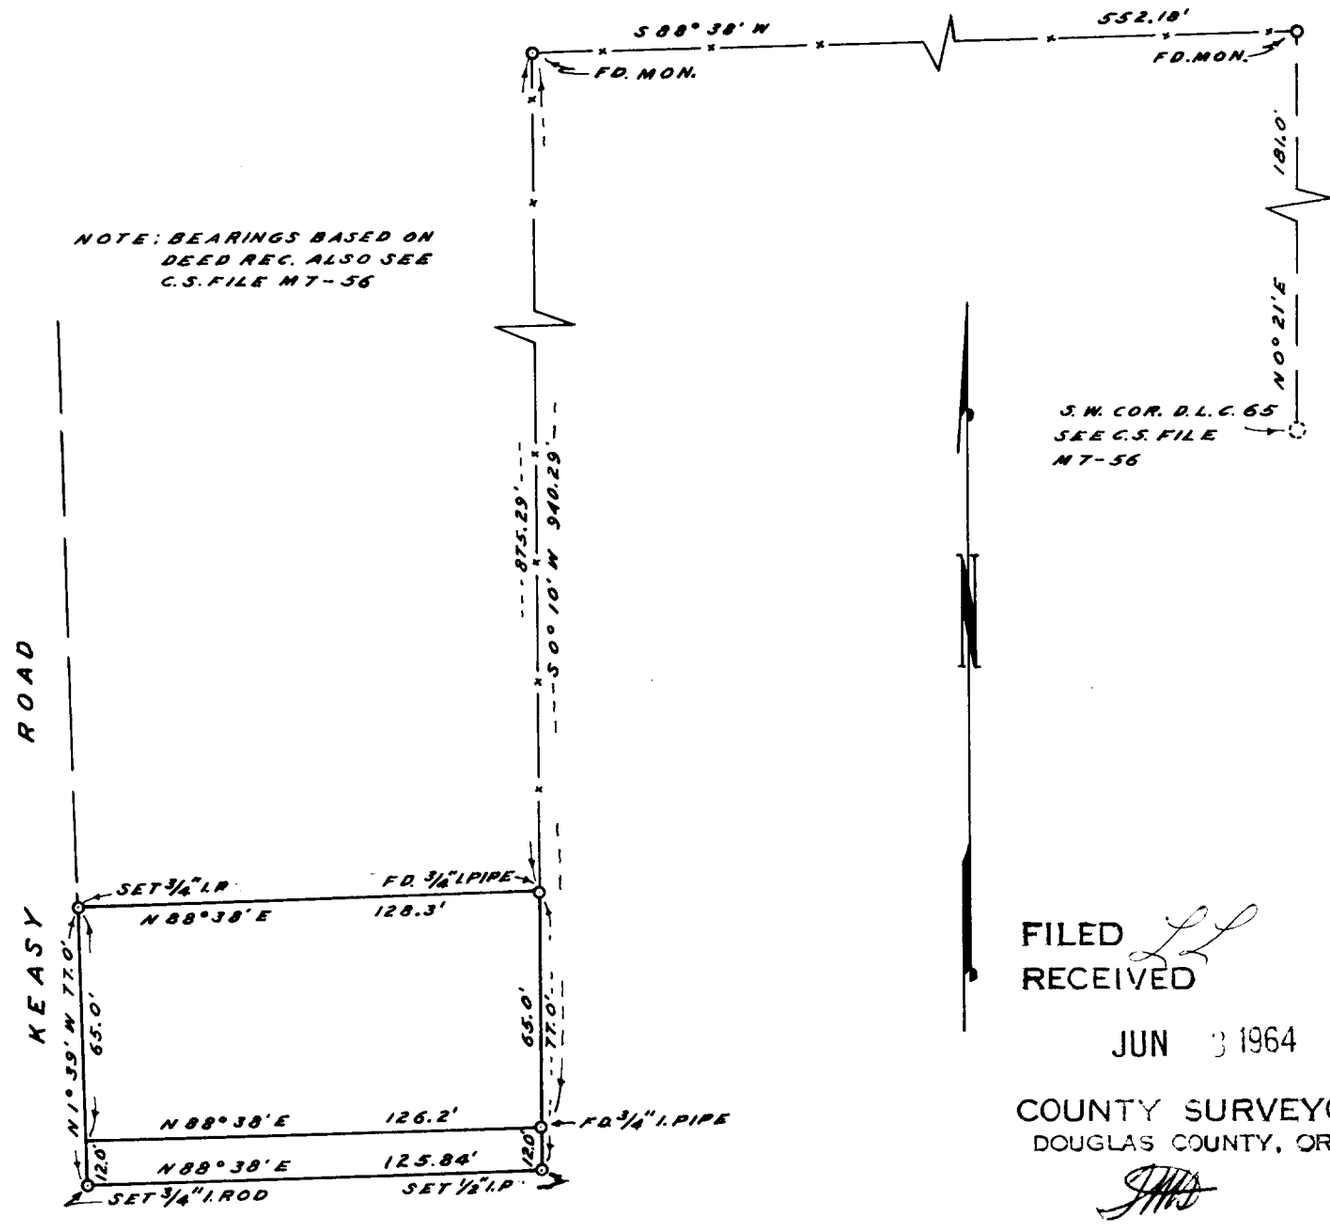

FILED
RECEIVED
JUN 3 1964
COUNTY SURVEYOR
DOUGLAS COUNTY, ORE.

P

C. S. File No. 51/285-5