T25-S Sec. 17DC

KIM PROPERTY IN BLOCK 19 · TOWNSITE of SUTHERLIN

DOUGLAS COUNTY OREGON

Yohann Kim

COUNTY SURVEYOR FILE DATA
DO NOT REMOVE FROM OFFICE

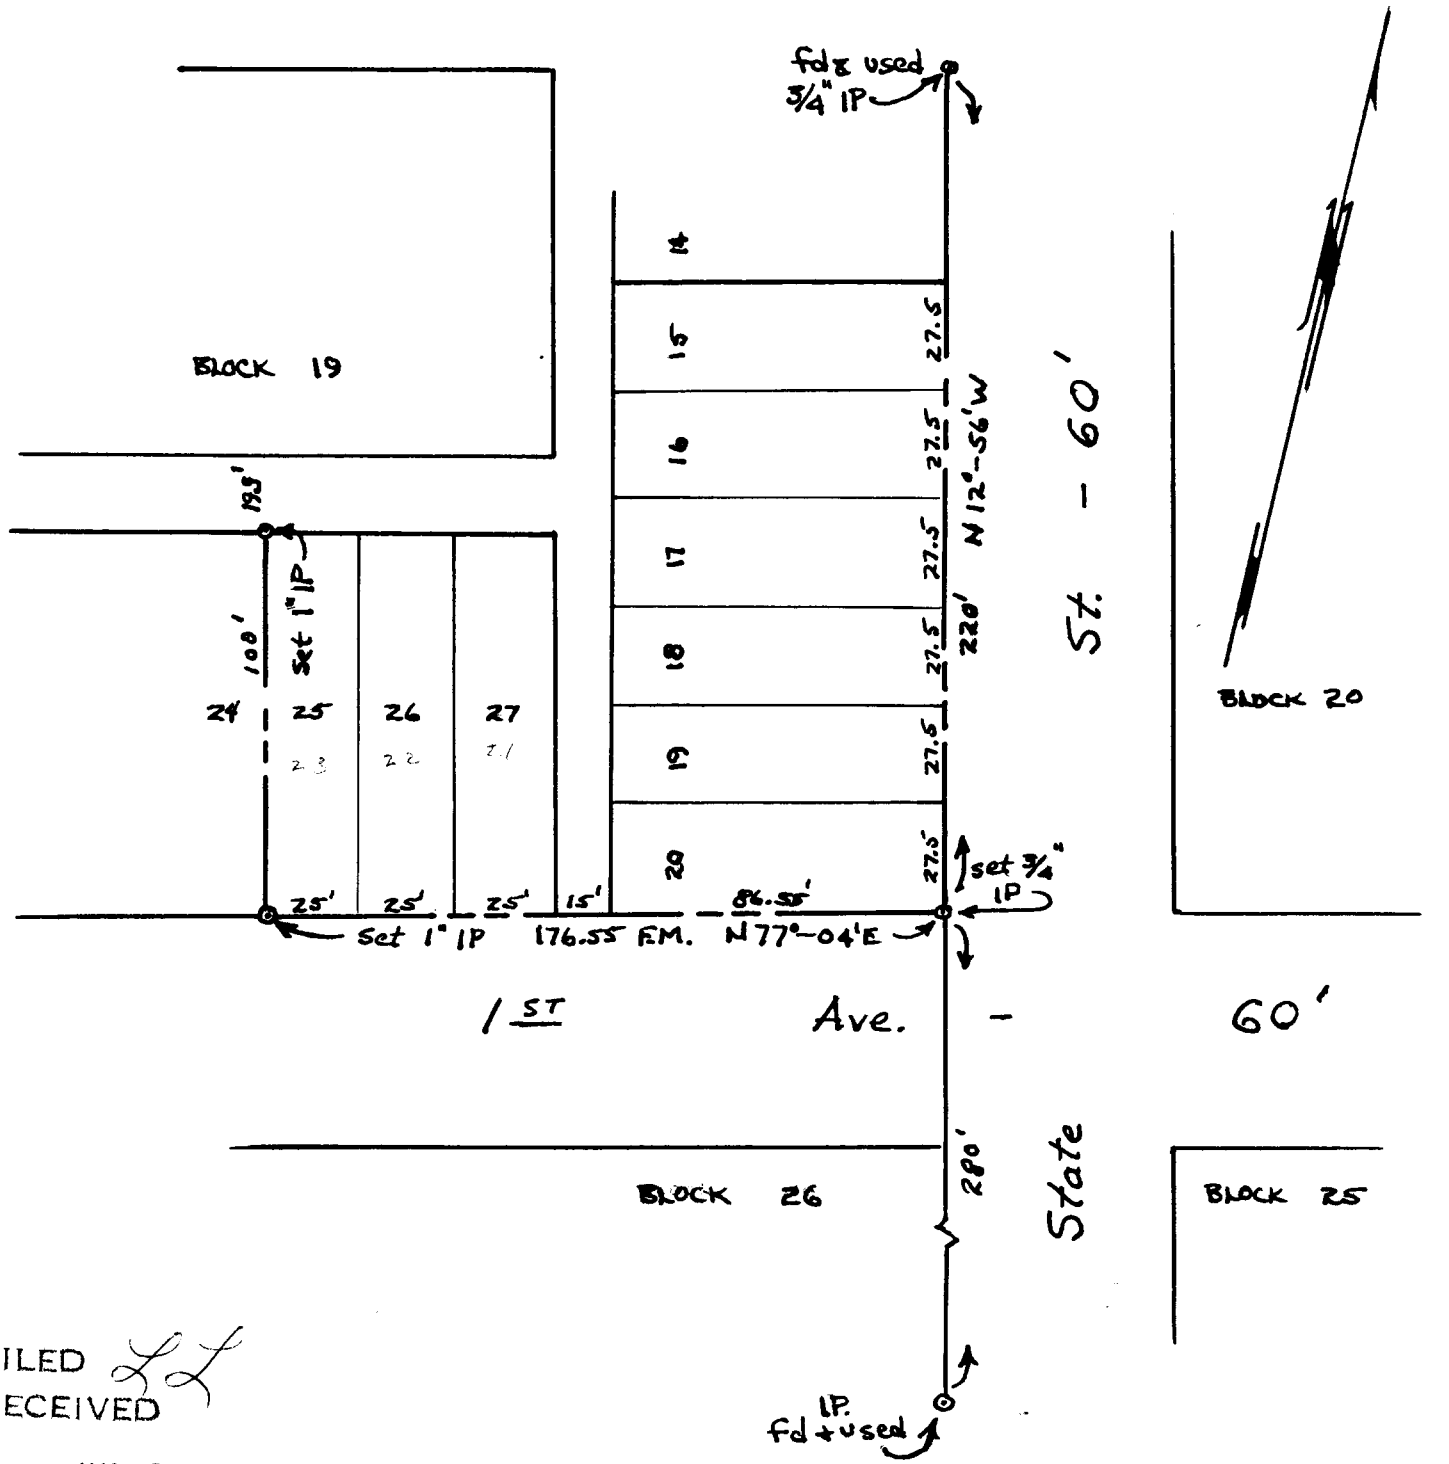

FILED
RECEIVED
JUN 26 1964
COUNTY SURVEYOR
DOUGLAS COUNTY, ORE.

April 13, 1964
Scale 1" = 50'

JAMES R. DAUGHERTY
CIVIL-SANITARY ENGINEER
WINSTON, OREGON

REGISTERED PROFESSIONAL ENGINEER 2230 OREGON NOV. 10, 1944 JAMES R. DAUGHERTY

File No. BW
C.S. 51/291-2