T.27-6 Sec. 12AD

SURVEY of LOT 10 · BLOCK 2 · CLOVER KERR SUBDIVISION

ROSEBURG
OREGON

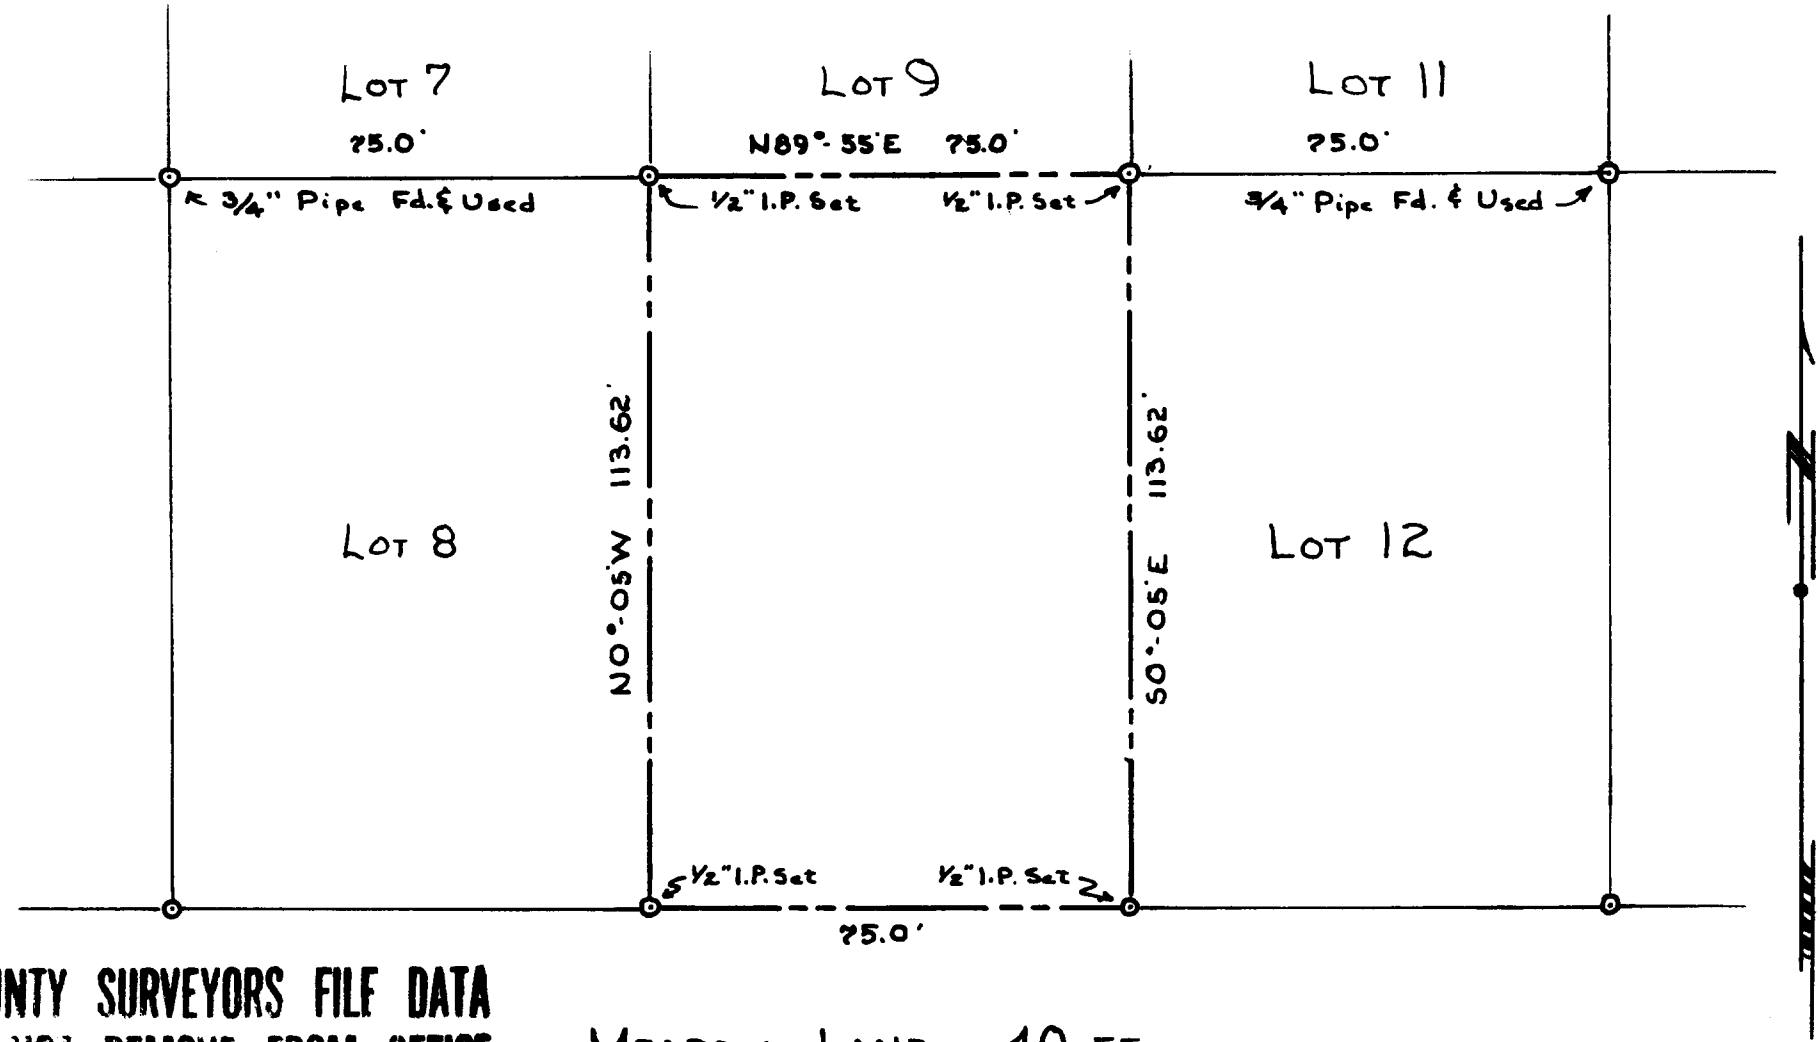

COUNTY SURVEYORS FILE DATA
DO NOT REMOVE FROM OFFICE

MEADOW LANE 40 FT.
S89°-55'W

FILED
RECEIVED
AUG 14 1964
COUNTY SURVEYOR
DOUGLAS COUNTY, ORE.

REGISTERED PROFESSIONAL ENGINEER
James R. Daugherty
OREGON
NOV. 10, 1944
JAMES R. DAUGHERTY

SCALE : 1" = 30'

JUNE 26, 1964
For RICHARD D. CROSS

JAMES R. DAUGHERTY
CIVIL-SANITARY ENGINEER
WINSTON, OREGON

P.B.

C.S. File No. 51/291-4