COUNTY SURVEYOR FILE DATA
DO NOT REMOVE FROM OFFICE

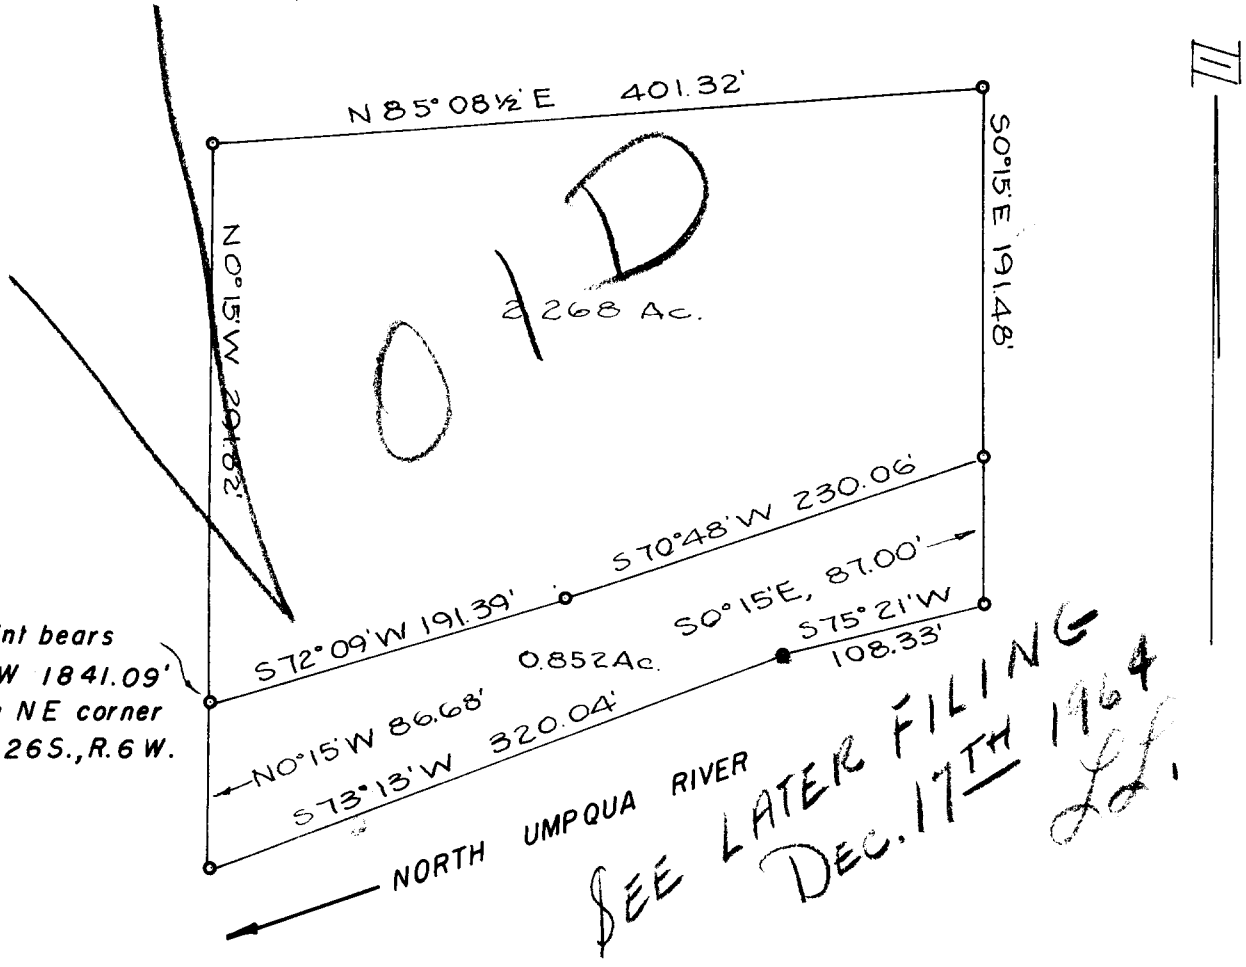

SURVEY FOR DEED DESCRIPTION
SURVEYED FOR JOHNIE L. DENTON
LOT 2, ROSEBURG HOME ORCHARD TRACTS PLAT E
SECTION 32, T. 26 S., R. 6 W., W.M.
SURVEYED BY R. H. GEE
OCTOBER, 1964 — SCALE 1" = 100'

FILED
RECEIVED

DEC 14 1964

COUNTY SURVEYOR
DOUGLAS COUNTY, ORE.

REGISTERED PROFESSIONAL ENGINEER
3723
R. H. Gee
OREGON
OCT. 22, 1954
R. H. GEE

C. S. File No. 51/297-3