KIRBY BIAS PROPERTY IN LOTS 152 & 153 - TRACT 1 - PLAT 1 - RO Co.

ROSEBURG ORCHARDS CO. T 27S R 5W SEC. 7
DOUGLAS COUNTY ORE.

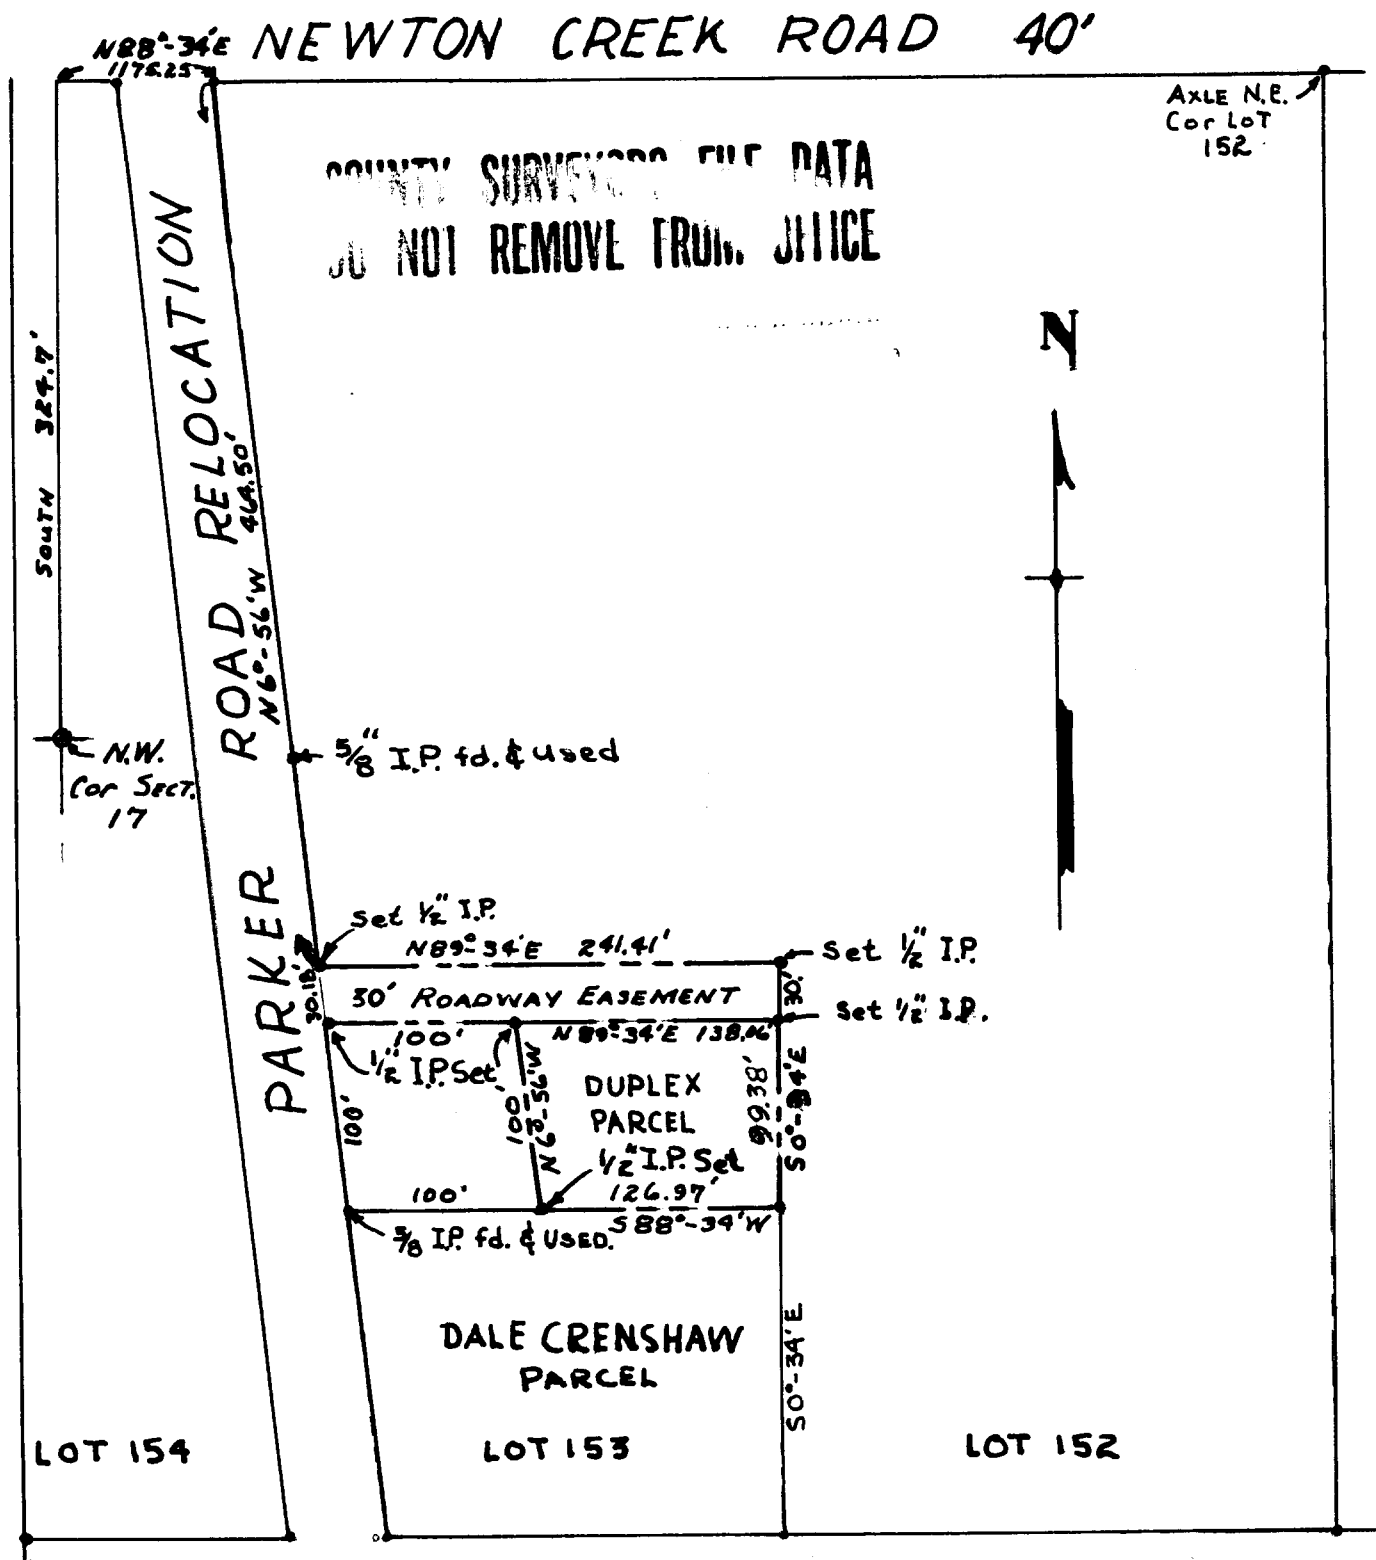

FILED
RECEIVED
JAN 1 1964
COUNTY SURVEYOR
DOUGLAS COUNTY, ORE.

PLATTED BY
JAMES R. DAUGHERTY
CIVIL-SANITARY ENGINEER
WINSTON, OREGON

REGISTERED PROFESSIONAL ENGINEER 2328 James R. Daugherty OREGON NOV. 10, 1948 JAMES R. DAUGHERTY

C. S. File No. 51/303-6