T22S R6W

Corner 4-5-8-9 is in danger of being destroyed in Road Construction. I therefore put in reference Points.

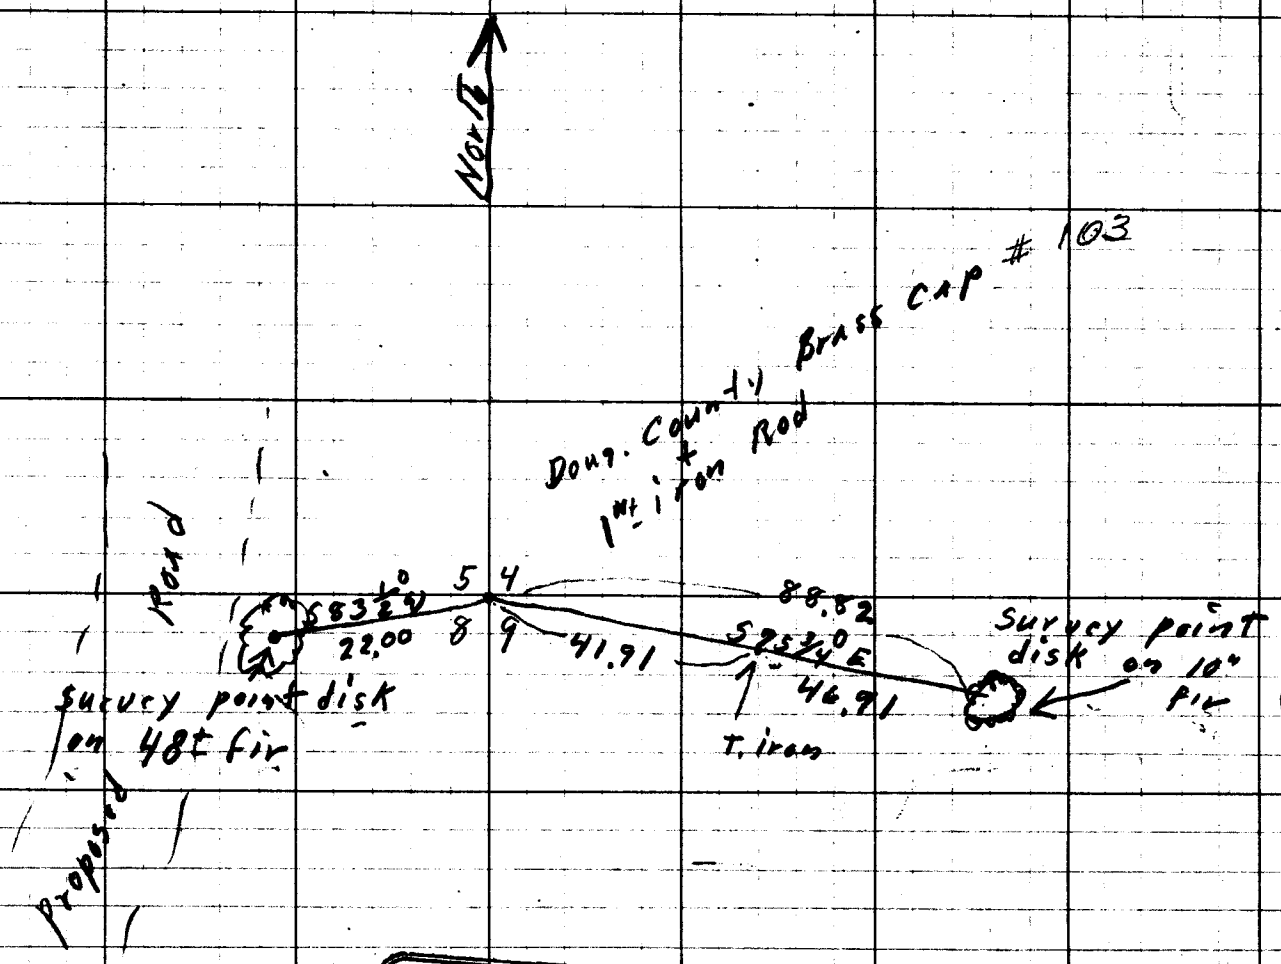

REGISTERED
OREGON
LAND SURVEYOR
Wilford N. Haines
MAY 7, 1948
WILFORD N. HAINES
239

FILED
RECEIVED
JUN 10 1966
COUNTY SURVEYOR
DOUGLAS COUNTY, ORE.

Ren #118

C. S. File No. 39/1009-4