SURVEYED FOR DEED DESCRIPTION
IN SECTION 1, T.26S., R.3W. W.M.
SURVEYED FOR KEN OVERTON
BY BAUGHMAN SURVEYING SERVICE
SCALE 1"=100' OCT. 9, 1966

• SET 3/4" IRON ROD
◦ AS SHOWN

COUNTY SURVEYORS FILE DATA
DO NOT REMOVE FROM OFFICE

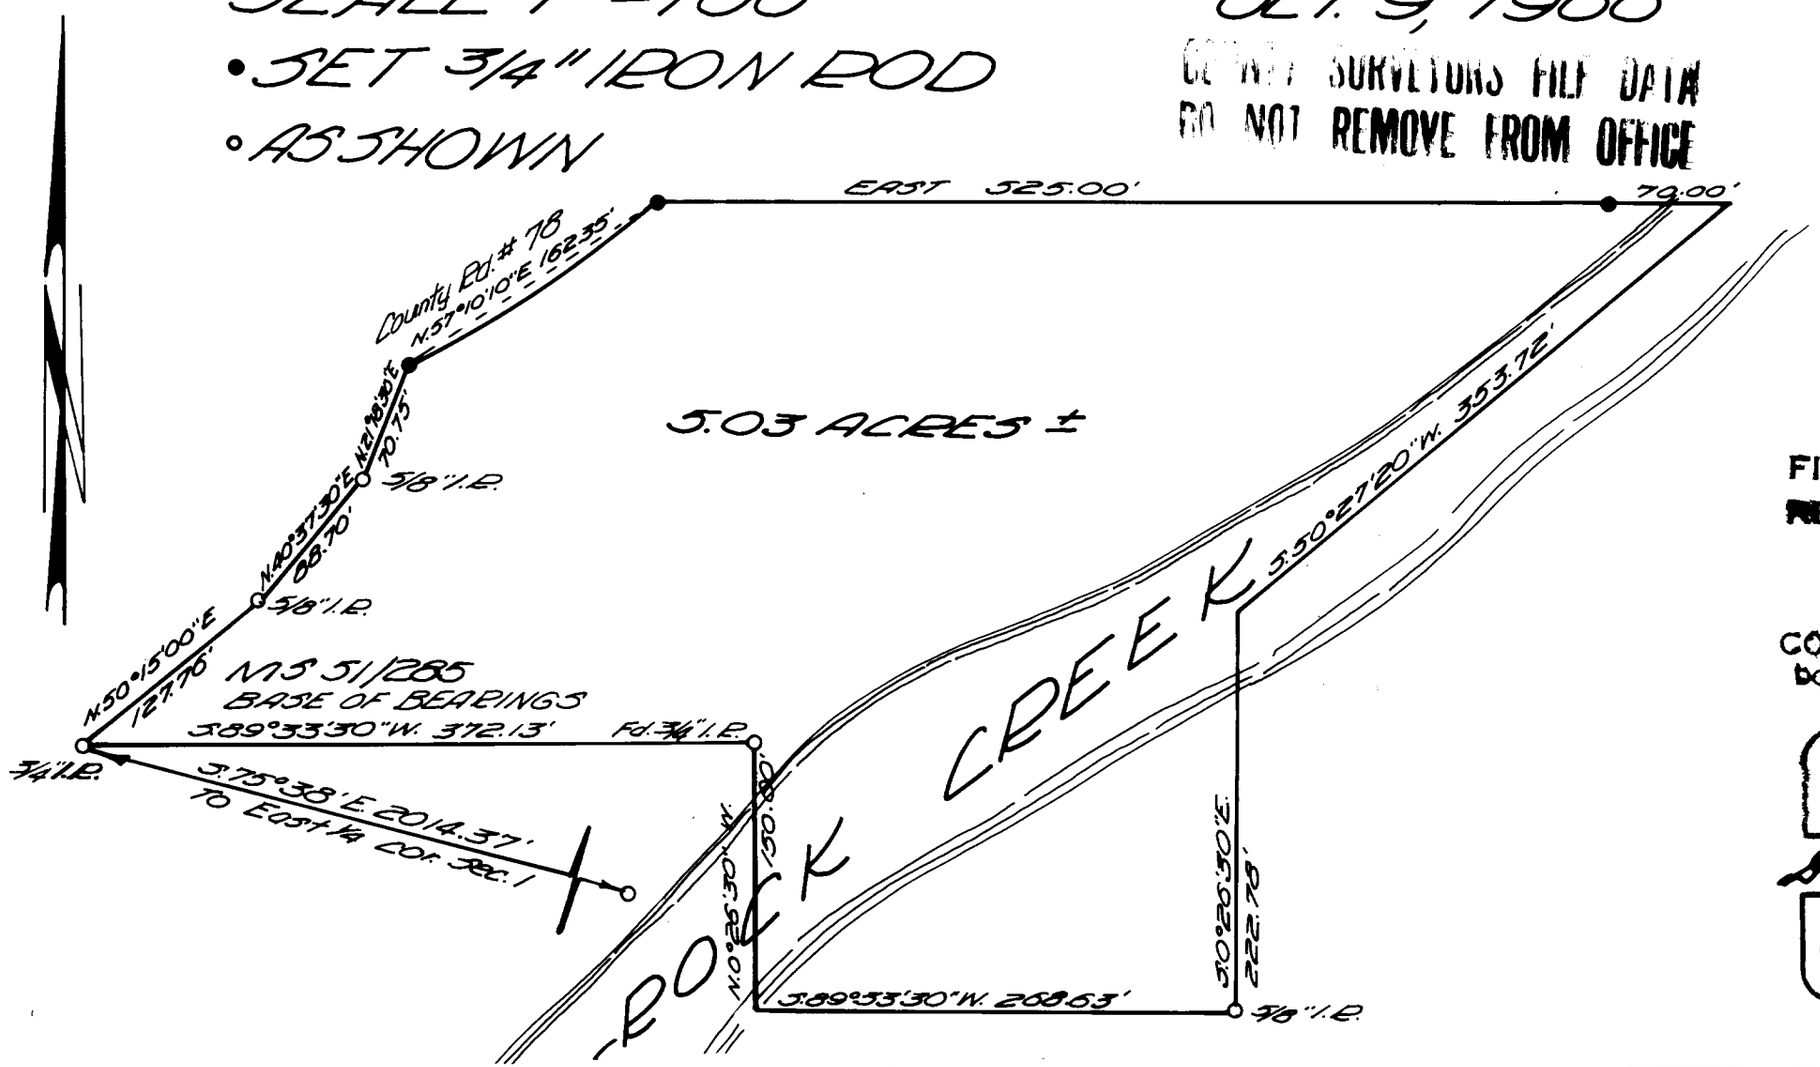

FILED
RECEIVED
DEC 12 1966
COUNTY SURVEYOR
DOUGLAS COUNTY, ORE.

REGISTERED
OREGON
LAND SURVEYOR

Glenn S. Baughman

JULY 14, 1961
GLENN S. BAUGHMAN
536

C. S. File No. 51/315