T.27-S R.2W

LOT 4, AND LOT 3, LESS THE SOUTHERLY 30' OF LOT 3, BLOCK "A"
HAWTHORNE TERRACE, A SUBDIVISION OF KINNEAR HEIGHTS TRACT
ROSEBURG, OREGON
SURVEYED FOR RICHARD E, MOREHEAD NOVEMBER 2, 1965
SURVEYED BY BRUCE R. ROGERS SCALE 1" EQUALS 30'.

This is to certify that I have surveyed the property depicted herein and that the improvements shown do not encroach on the adjoining property.

BEARINGS ARE BASED ON THE EAST LINE OF HAWTHORNE DRIVE, AS PER SUBDIVISION RECORDED IN VOL. 6, PAGE 15, DEED RECORDS OF DOUGLAS COUNTY, OREGON.

COUNTY SURVEYOR'S FILE DATA
DO NOT REMOVE FROM OFFICE

FILED
RECEIVED
NOV 8 1965
COUNTY SURVEYOR
DOUGLAS COUNTY, ORE.

REGISTERED
OREGON
LAND SURVEYOR

Bruce R. Rogers

JULY 10, 1964
BRUCE R. ROGERS
660

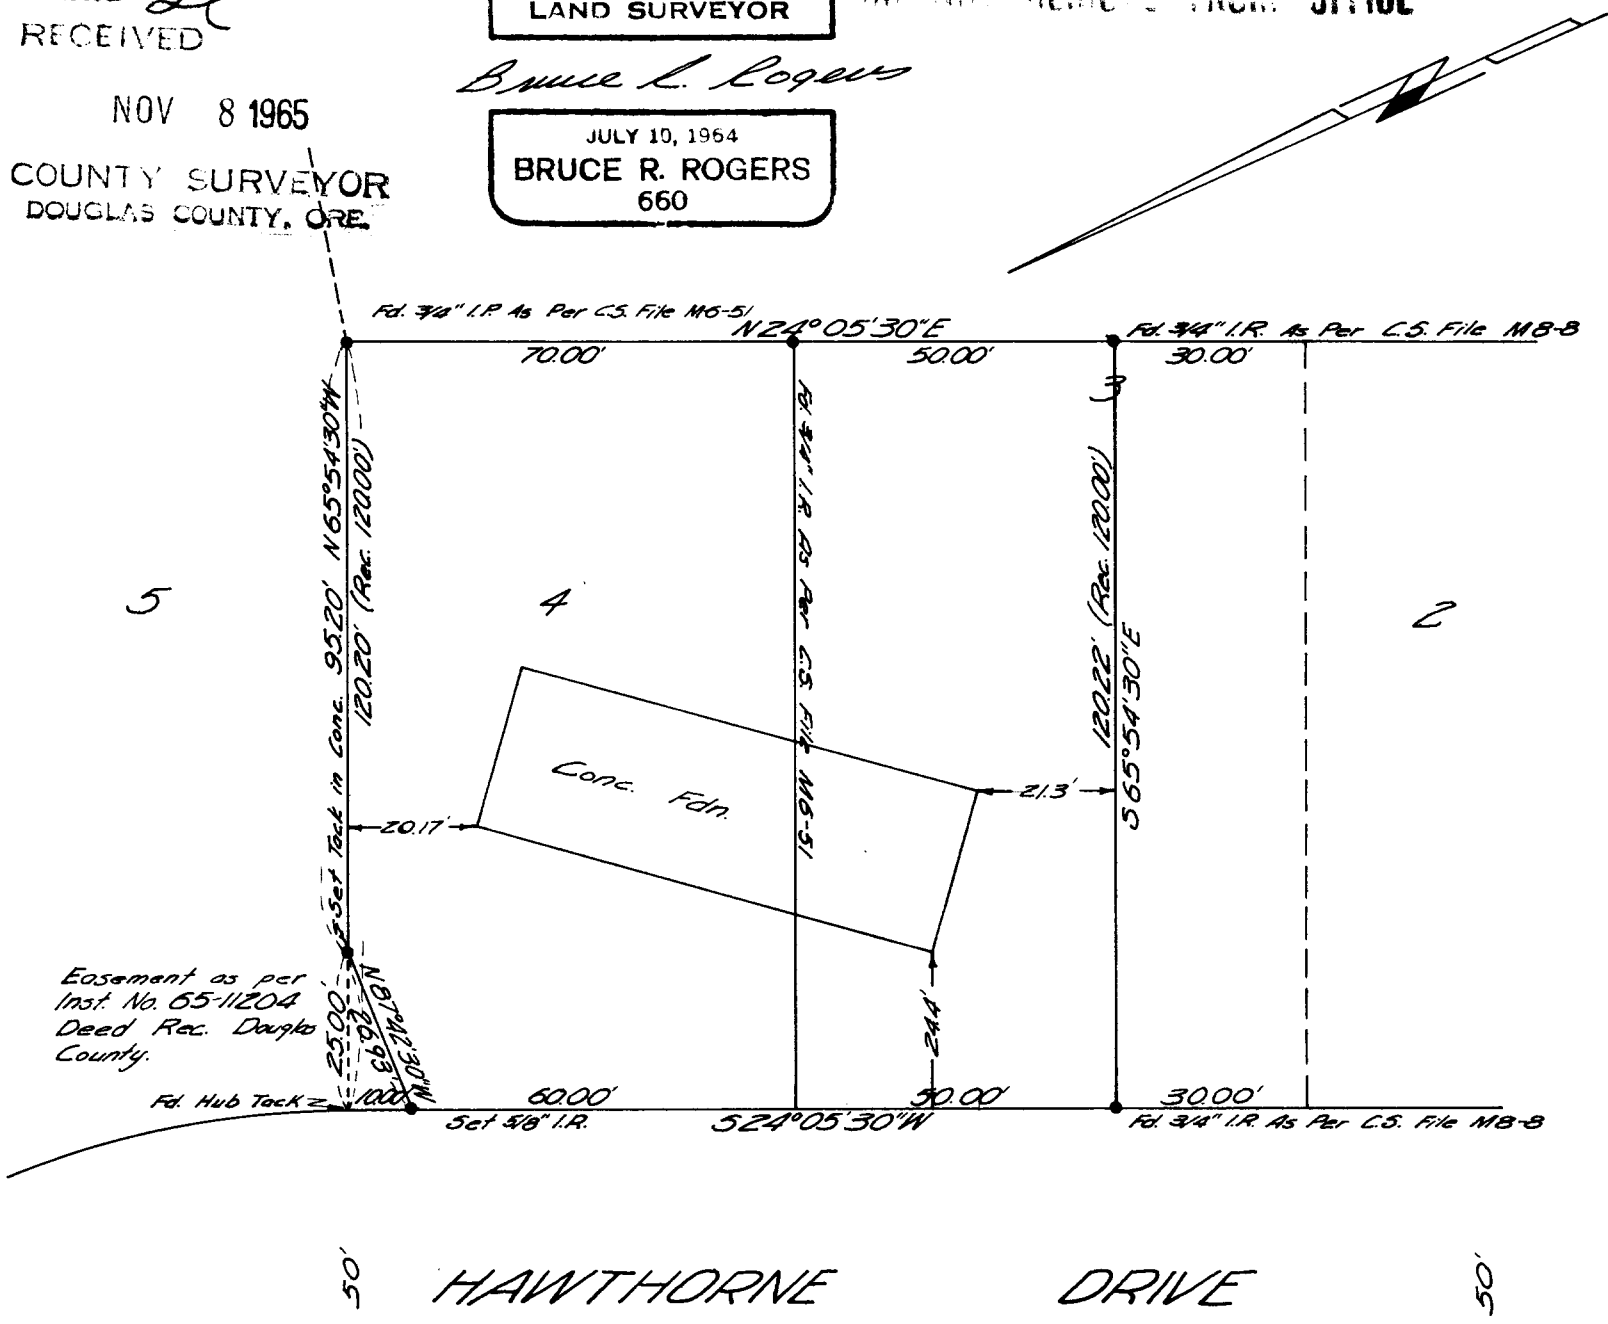

C. S. File No. 51/319-3