FILED LL
RECEIVED
NOV 1965
COUNTY SURVEYOR
DOUGLAS COUNTY, ORE.

T.27-5 Sec. 30 BD

A Survey to establish property corners
Lots 13 & 14 Block 3, Millers Addition
To the City of Roseburg, Oregon
Surveyed for Elwood Houston Nov. 6, 1965
Surveyed by Bruce R. Rogers Scale 1"=50'
Bearings are based on the Westerly line of Stormer St. N43°30'E, as platted.

REGISTERED
OREGON
LAND SURVEYOR
Bruce R. Rogers
JULY 10, 1964
BRUCE R. ROGERS
660

COUNTY SURVEYOR'S FILE DATA
DO NOT REMOVE FROM OFFICE

Note: The Rec. dimensions of lots 7 thru 14 are 47.75' by 100.00'.

Note: The Fd Mons. shown are recorded in C.S. File No. 42/185 and C.S. File No. 47/200

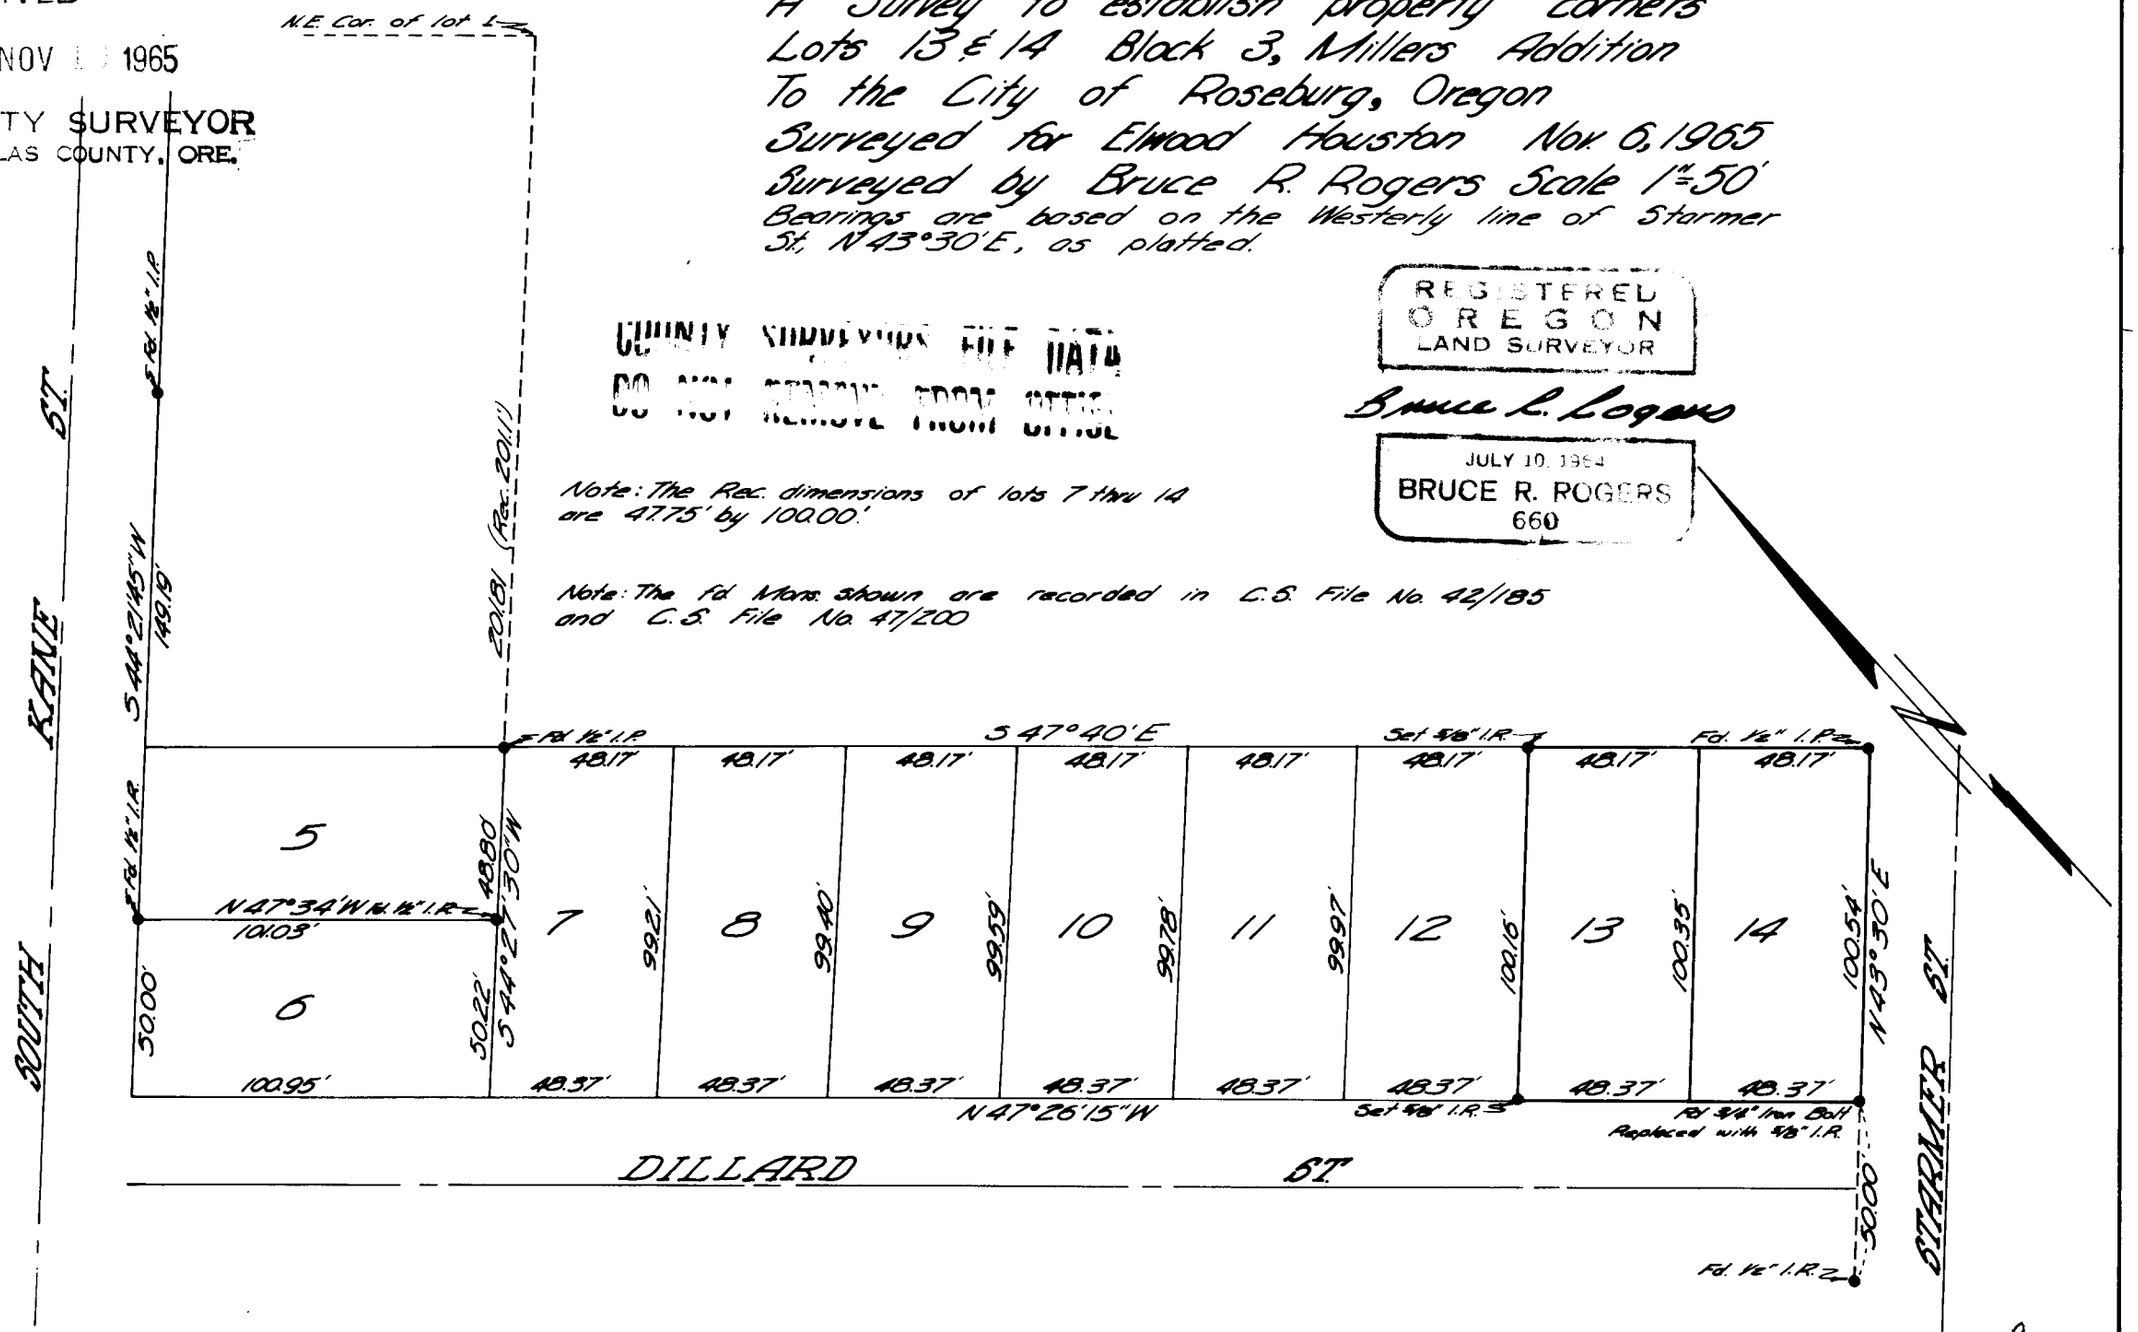

P
51/319-4