A SURVEY IN THE FRED GOETZ SUBDIVISION
IN SEC. 11 T.27S. R.6W. WIL. MER.
SURVEYED FOR UMPQUA REALTY
SURVEYED BY GLENN S. BAUGHMAN OCT. 3, 1965

COUNTY SURVEYORS FILE DATA
DO NOT REMOVE FROM OFFICE

REGISTERED
OREGON
LAND SURVEYOR
Glenn S. Baughman
JULY 14, 1971
GLENN S. BAUGHMAN
536

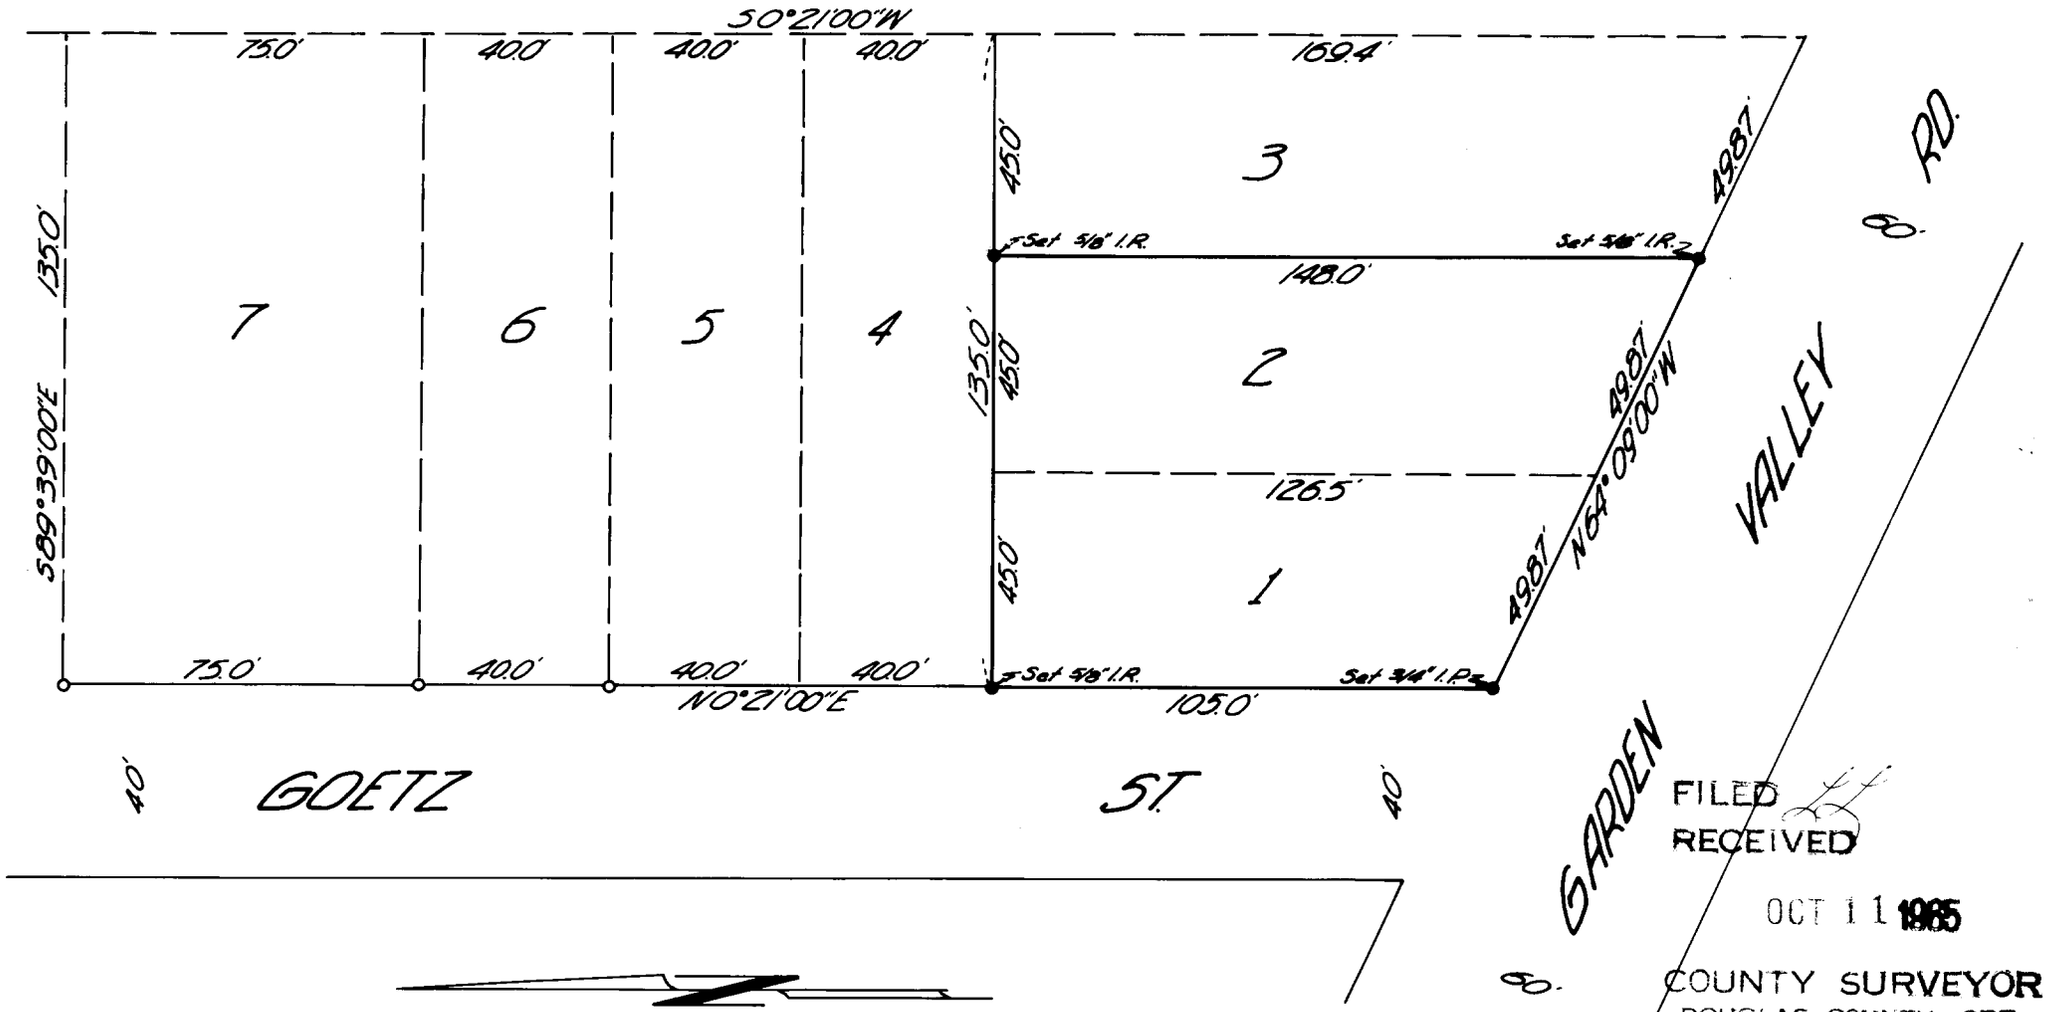

FILED
RECEIVED
OCT 11 1965
COUNTY SURVEYOR
DOUGLAS COUNTY, ORE.

File No. 51/322-1