COUNTY SURVEYORS FILE DATA
DO NOT REMOVE FROM OFFICE

NW 1/4 NW 1/4 SEC. 23 T27S R6W W.M.
SURVEYED FOR BOB HORN REAL ESTATE
SURVEYED BY DON E. GARRETT
JANUARY 4, 1966
SCALE 1" = 60"

FILED
RECEIVED
JAN 5 1966
COUNTY SURVEYOR
DOUGLAS COUNTY, ORE.

REGISTERED
OREGON
LAND SURVEYOR
Don E. Garrett
JULY 14, 1961
DON E. GARRETT
544

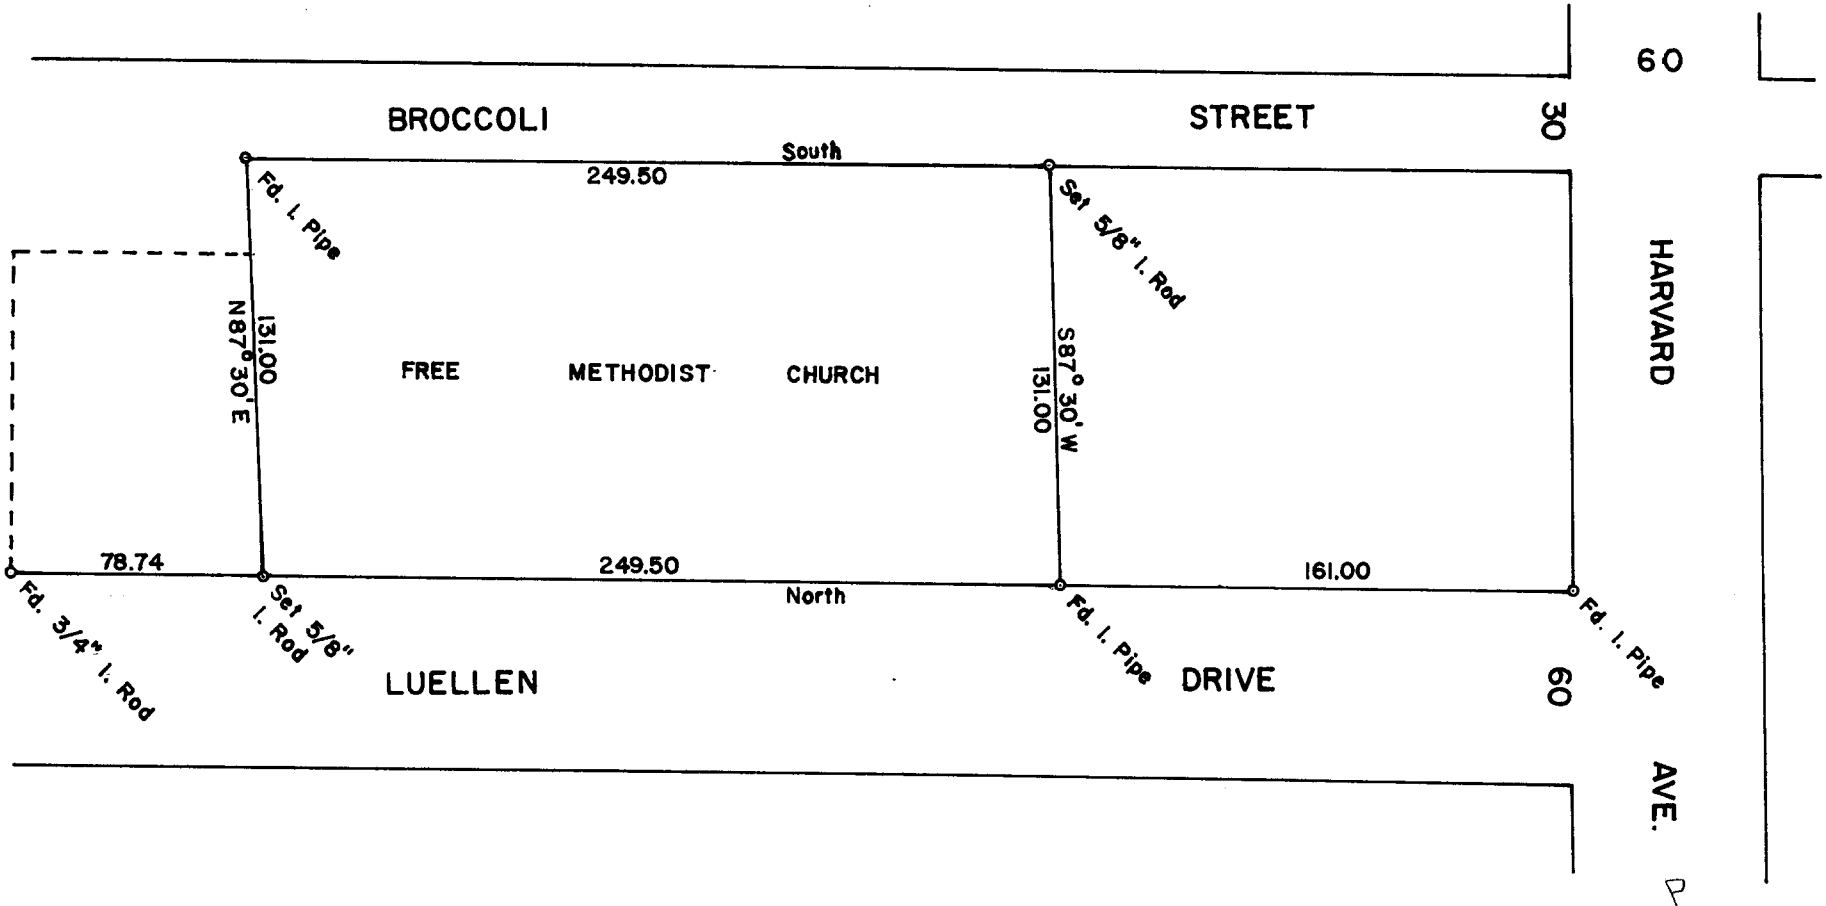

C.S. File No. 51/325-5