COUNTY SURVEYORS FILE DATA
DO NOT REMOVE FROM OFFICE

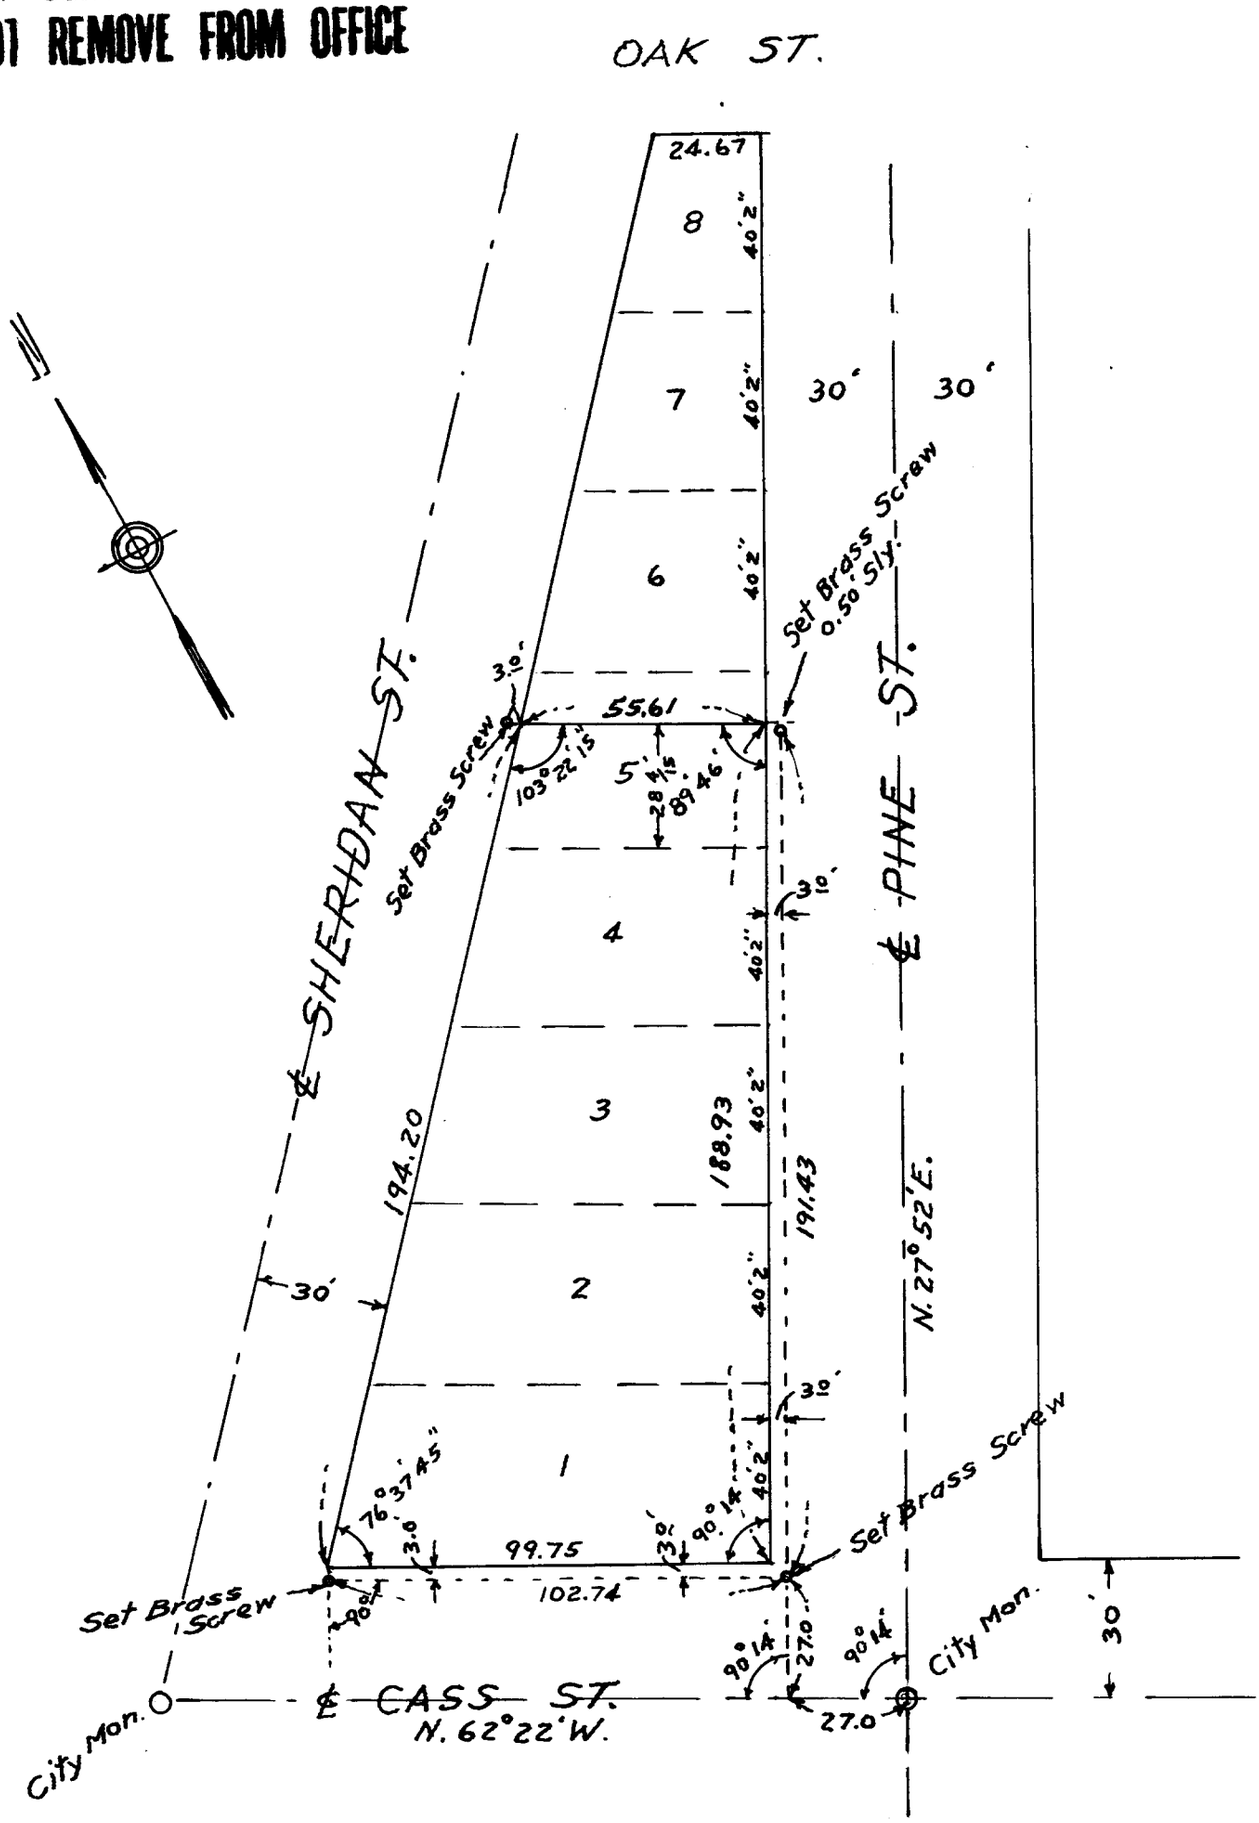

FILED
RECEIVED
NOV 16 1965
COUNTY SURVEYOR
DOUGLAS COUNTY, ORE.

REGISTERED PROFESSIONAL ENGINEER
1088
O. Stoehr
OREGON
SEPT. 11, 1920
O. STOEHR

SURVEY OF
LOTS 1, 2, 3, 4 & S'LY. 28 4/15 FT.
OF LOT 5 IN BLOCK 35
RAILROAD ADDITION TO CITY
OF ROSEBURG, OREGON.
IN NE. 1/4 SEC. 24, T. 27 S., R. 6 W., W.M.
DOUGLAS CO., ORE.

11/10/65 1" = 40'

C. S. File No. 51/328