COUNTY SURVEYORS FILE DATA
DO NOT REMOVE FROM OFFICE

FILED
RECEIVED
JAN 14 1966
COUNTY SURVEYOR
DOUGLAS COUNTY, ORE.

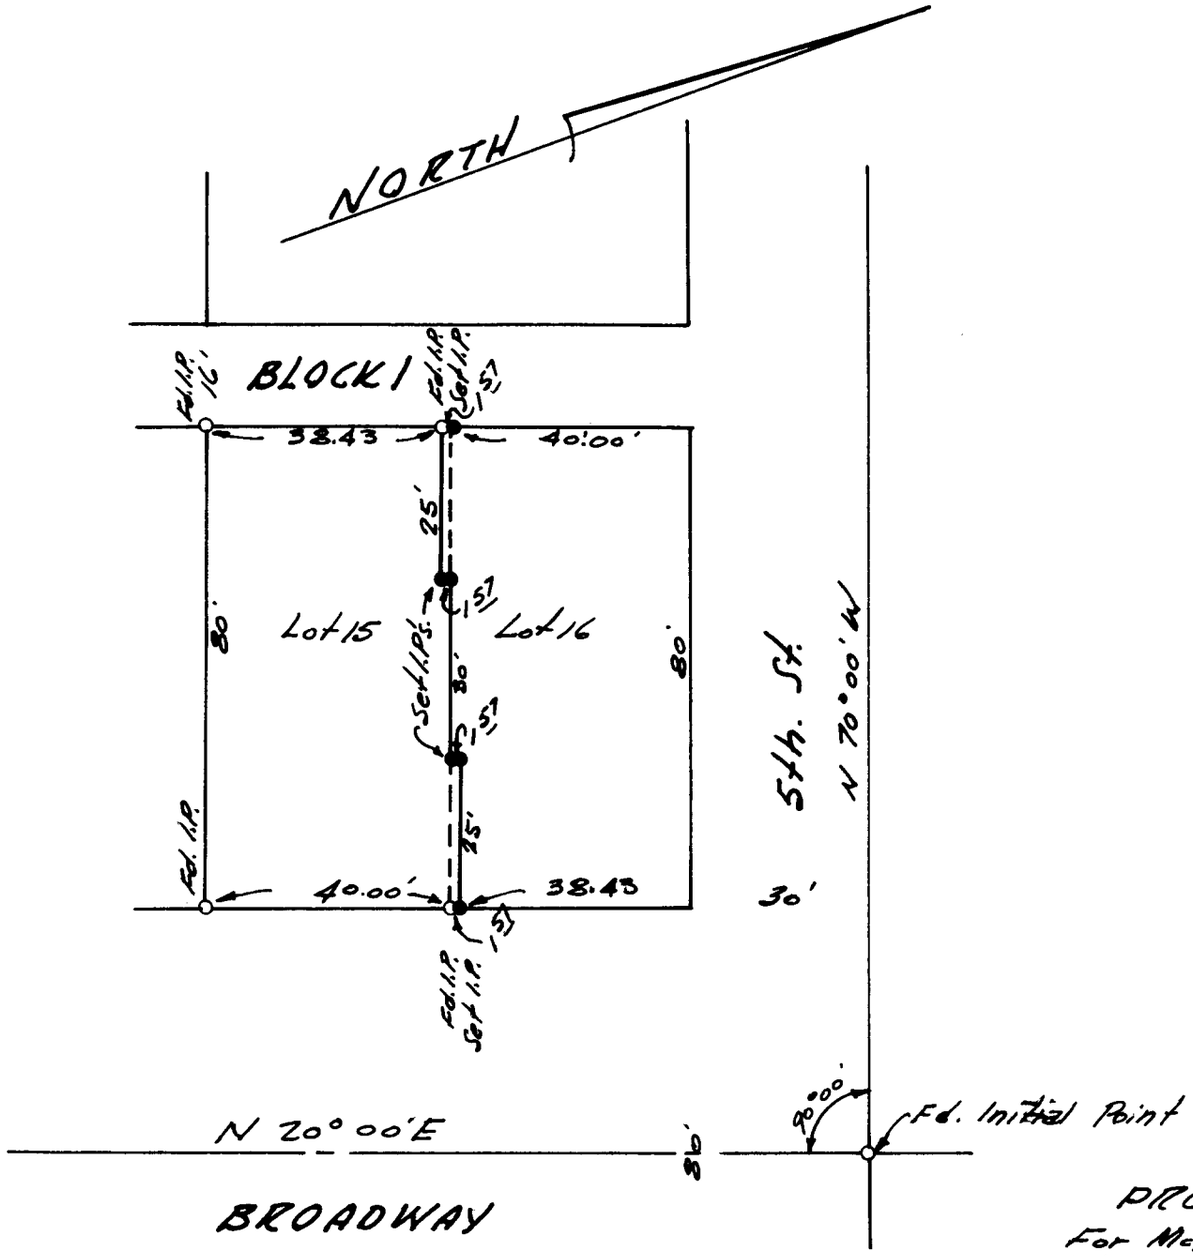

REGISTERED
OREGON
LAND SURVEYOR
Robert W. Wade
OCTOBER 4 1957
ROBERT W. WADE
433

PROPERTY SURVEY
For McNutt & Gant - Attorneys
Lots 15 & 16, Block 1, Plat of Winchester Bay, Douglas County, Oregon
Scale: 1" = 30' 6-1-65

R.H. Erichsen & Associates
Coos Bay, Oregon

T. 22-12 SE NW 1/4 S. 7 Map No. 51/3332