COUNTY SURVEYORS FILE DATA
DO NOT REMOVE FROM OFFICE

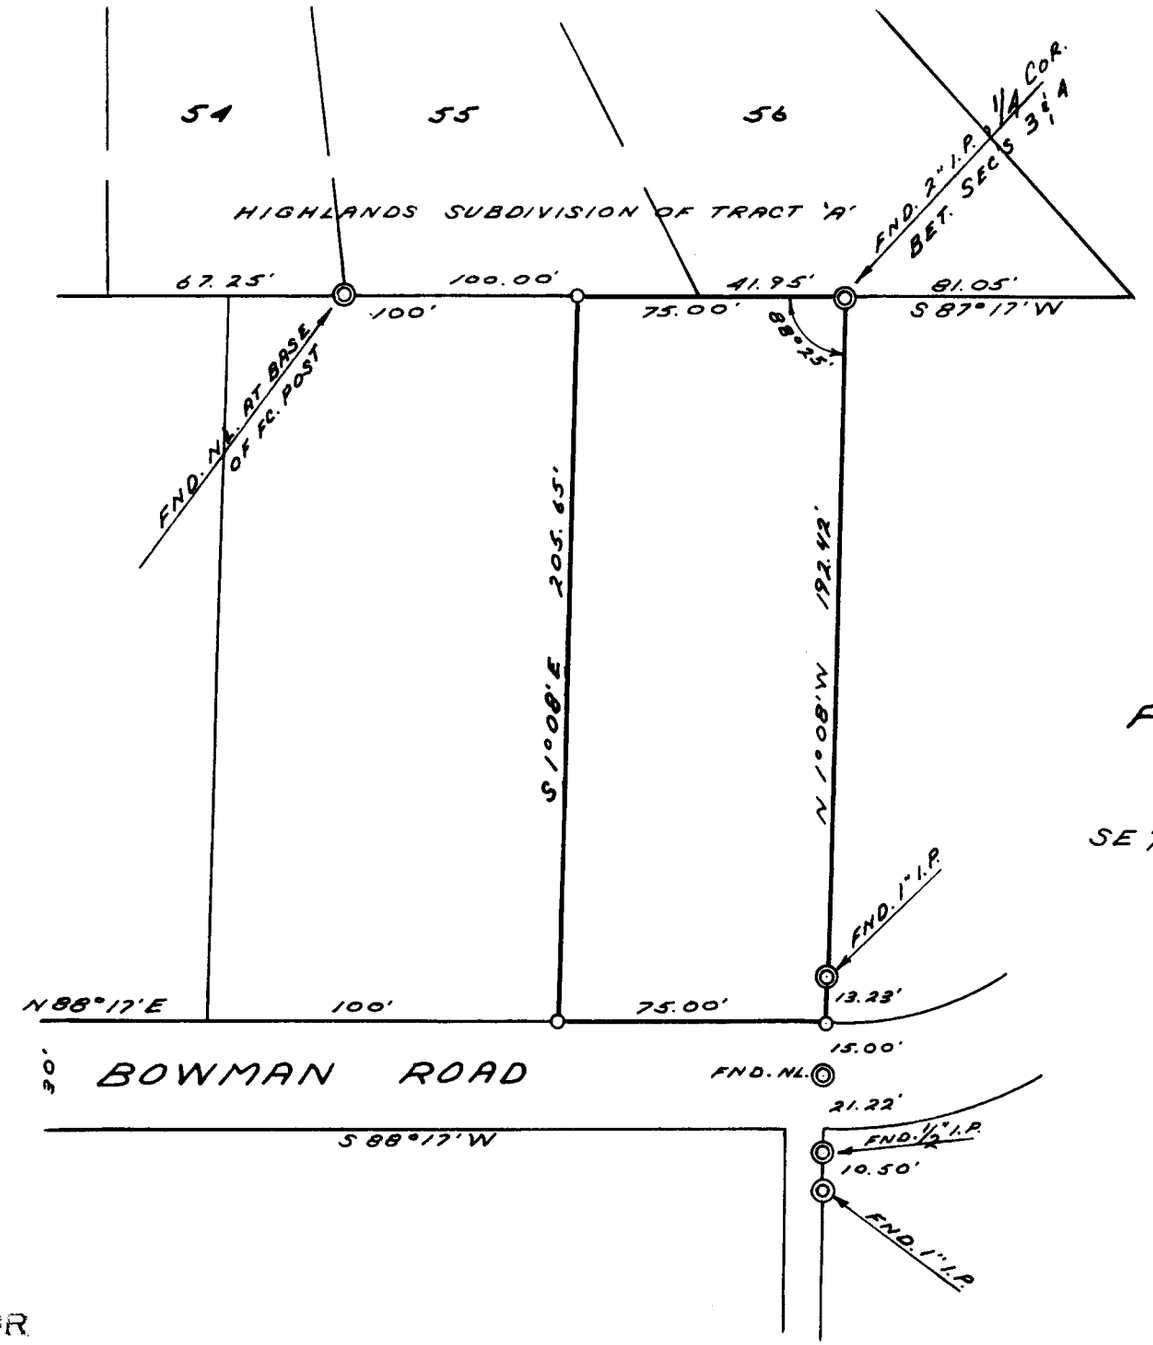

PROPERTY SURVEY FOR HARRY LUDWIG

SE 1/4, SEC. 4, T 22 S, R 12 W, W. M.
FEB. 14, 1966 SCALE: 1" = 50'
SET 3/4" I.P.'S O

NORTH

FILED
RECEIVED
MAR 7 1966
COUNTY SURVEYOR
DOUGLAS COUNTY, ORE.

REGISTERED
OREGON
LAND SURVEYOR
Richard J. Hintz
MAY 13, 1960
RICHARD J. HINTZ
497

Filing No. 51/335-P