

RESTORED CORNER FOR STATE OF OREGON--DEPARTMENT OF FORESTRY

Closing corner for Sections 20 and 29, east end, Township 22 South, Range 11 West, W.M., Douglas County, Oregon.

ORIGINAL

Stone 20" x 12" x 10" (found in place, badly sloughed, one notch and other chisel work remaining on West side) from which a:

6" Cherry bears S75W 24 lks.; rotted and down, root hole in place.

7" Cherry bears N48W 20 lks.; clump of cherries in place, old face on one.

6" Myrtle bears N81E 20 lks.; large clump of 17 in place.

RESTORED

Set 1½ x 36" galvanized iron pipe with 3" bronze cap marked "OREGON STATE BOARD OF FORESTRY T22S, R11W, S20 S29 CC S28 1966 RS 359", 28 inches in ground, on North side corner stone, in mound of rock, and from which a:

12" Myrtle bears N83½E 15.9 ft.; scribed T22S R11W S28 BT.

10" Myrtle (in clump of 11) bears South 8.4 ft.; scribed T22S R11W CC S29 BT RS 359.


53" Fir bears N9W 49.4 ft.; scribed T22S R11W CC S20 BT.

Set 4" x 4" x 72" white painted Cedar post 1.5 ft. SW of corner pipe.

Oregon State Forestry Department metal location poster on 12" Myrtle BT.

Dated March 30, 1966

Restored by

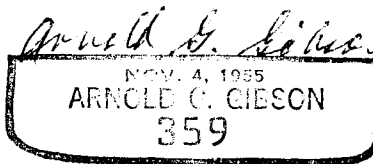

Present and witnessed by E. D. Kucera  
G. Gresham

FILED  
RECEIVED

MAR 31 1966

COUNTY SURVEYOR  
DOUGLAS COUNTY, ORE.