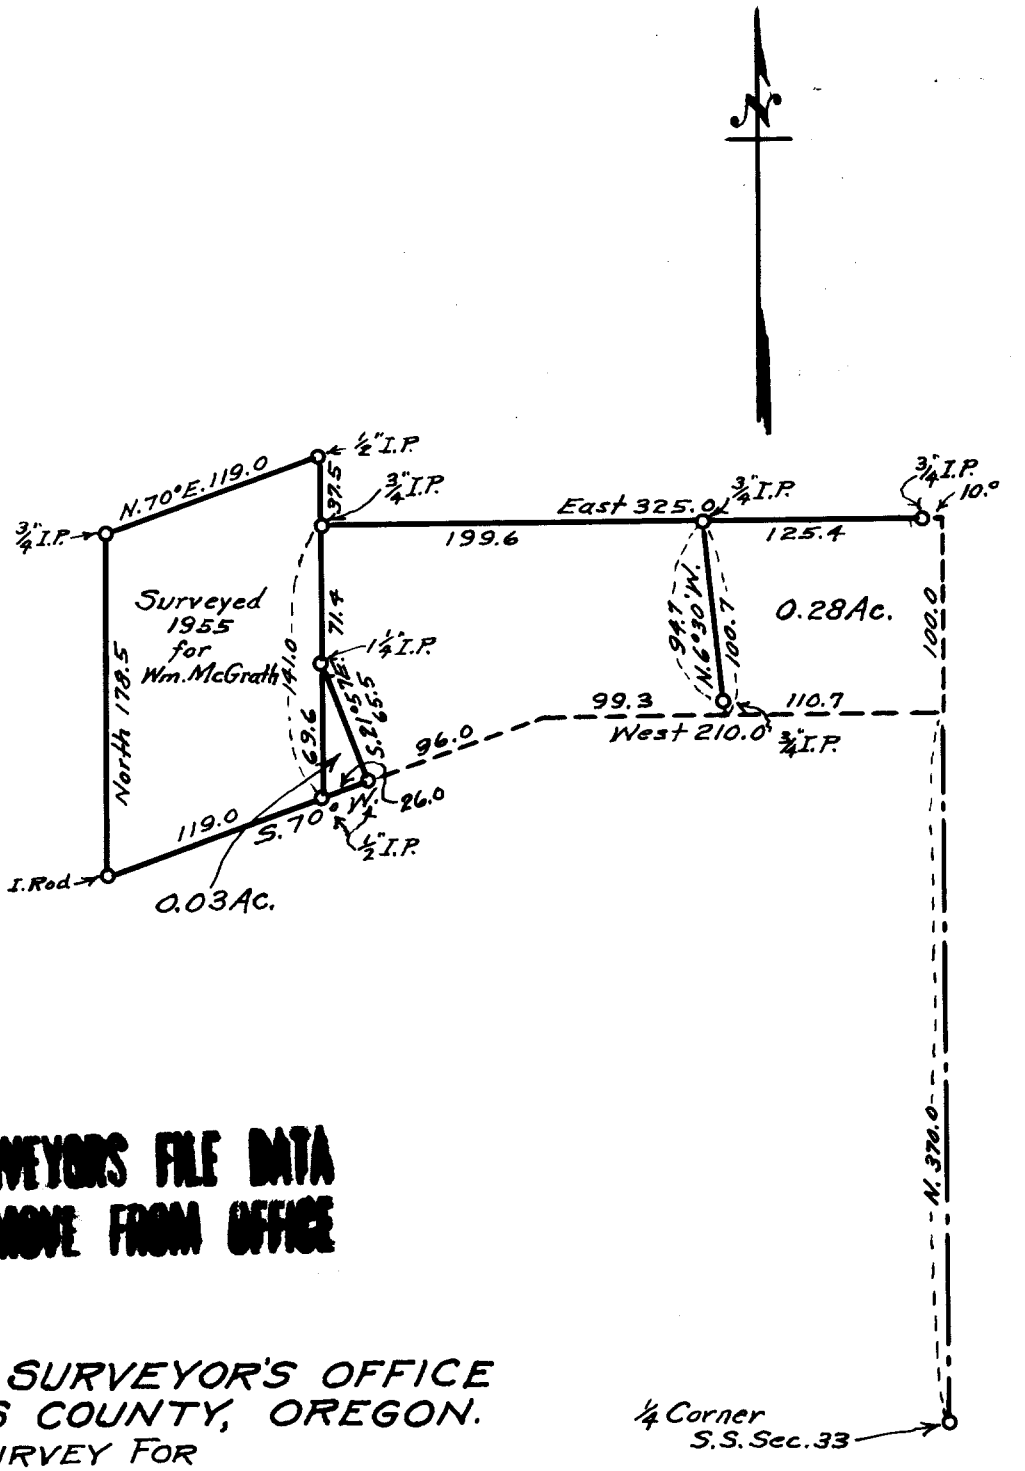

COUNTY SURVEYORS FILE DATA
DO NOT REMOVE FROM OFFICE

COUNTY SURVEYOR'S OFFICE
DOUGLAS COUNTY, OREGON.
SURVEY FOR
GEORGIA DARK
SECTION 33, T. 32 S., R. 6 W., W.M.
GEO. J. WENDEROTH, DEPUTY. NOV. 1959
Scale 1"=100ft.

REGISTERED
OREGON
LAND SURVEYOR
Geo. J. Wenderoth
MARCH 10, 1944
George J. Wenderoth

FILED
RECEIVED
NOV 23 1959
COUNTY SURVEYOR
DOUGLAS COUNTY, ORE.

C. S. File No 52/8

The bearing used was 3 Points.