COUNTY SURVEYOR'S FILE DATA
DO NOT REMOVE FROM OFFICE

C. S. File No. 52/123-1

FILED L.L.
RECEIVED
JUN 25 1962
COUNTY SURVEYOR
DOUGLAS COUNTY, ORE.

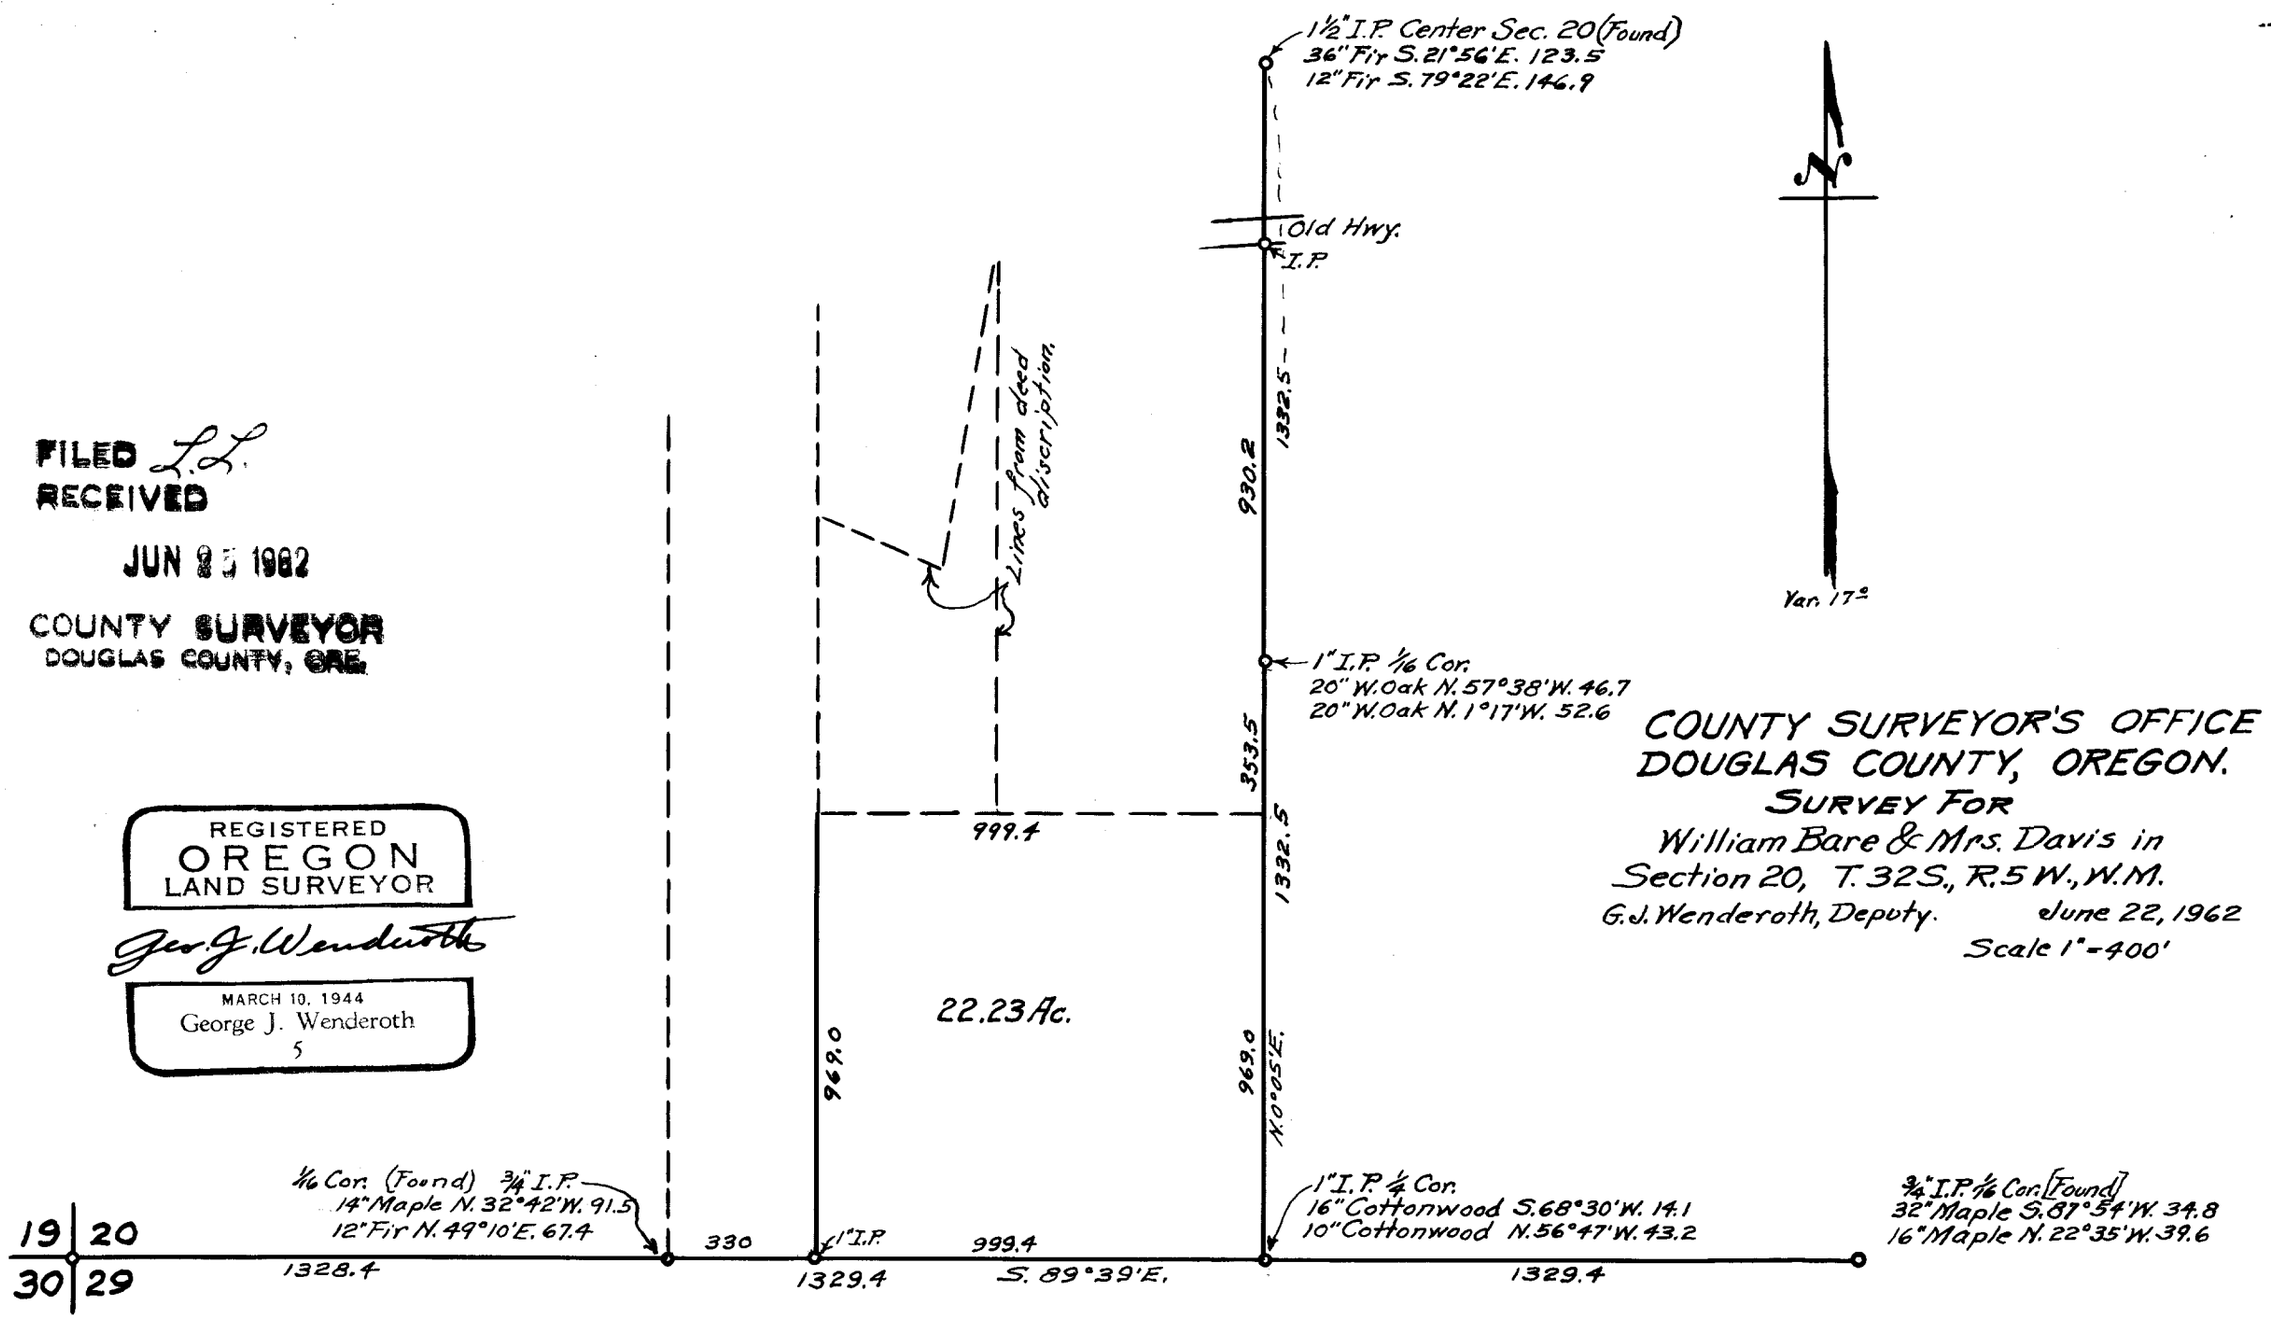

C. S. File No. 52/123