


PUBLIC LAND CORNERS

WEYERHAEUSER TIMBER COMPANY
SPRINGFIELD BRANCH

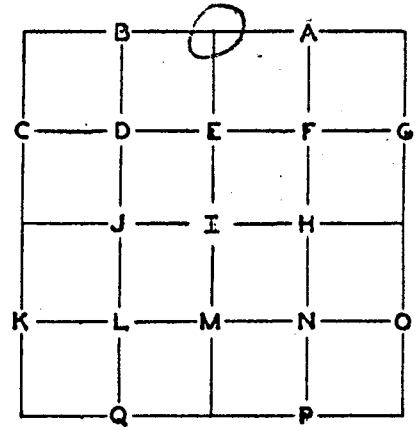

TOWNSHIP 235 RANGE 3W
 SECTION 18 CORNER N 1/4
 COUNTY Lane OREGON

GLO SURVEY RECORD

DATE: 1882
 CORNER 8" Vine Maple

PRESENT CONDITION - (DESCRIBE FULLY - USE PAGE 2 IF NEEDED FOR EXPLANATION.)

No Trace

ACCESSORIES:

	BEARING-	LINKS-	FEET-	
<u>5" Maple</u>	<u>N60W</u>	<u>6</u>	<u>4.0</u>	<u>No Trace</u>
<u>6" Hem</u>	<u>S8E</u>	<u>10</u>	<u>6.6</u>	<u>14" x 4' Stub Scribed "1/4" Visible.</u>

SURVEY RECORD

DATE: _____

PRESENT CONDITION: _____

CORNER SET: Yew Post by GLO dist. and bear. MAG. DECL: 20°
from SE BT

BEARING AND DISTANCE TO ABOVE IDENTIFIED SURVEY ACCESSORIES:

BEARING-	FEET-	SURVEY -	
<u>S8E</u>	<u>6.6</u>	<u>GLO</u>	<u>Hem. Stub</u>

CS 53 / 1-23
A

ACCESSORIES ADDED THIS DATE:

MAGNETIC DECLINATION 20°

1326

#29 ✓

	BEARING	FEET	ORIG. B.T.	"W" NAIL	PLATE	BRASS DISC
64" Fir	S40E	21.0		X	X	
8" Hem.	N64E	39.3		X	X	

IDENTIFIED ON PHOTO:

INFORMATION ON LOCATION OF CORNER AS NOW SET:

GROUND COVER: Thick Hemlock doghair - 5-10yr.

(USING FORM LINES SKETCH TOPOG AT CORNER ON PAGE 2 PLAT)

SLOPE FACES (GIVE BEARING IN DEGREES) N40E ON MINUS (-) 5 %

NORTH: -5% 25'; -35% 120' Stream c N40E logged E+W

SOUTH: +45% 10'; +15% 40'; +58% 90' Top Spur c N70E
Through old growth

EAST: -8% Logged to North, Old growth to South.

WEST: +8% Logged to North, Old growth to South.

FROM CORNER -

WORK DONE FOR W. T. CO.:

FIELD NOTES IN BOOK:

BY: Allen McCreary DATE: 4-1-58
ENGINEER - SURVEYOR

UNDER THE SUPERVISION OF:

ASSISTED BY:

COPIES SENT TO:

SEAL

PAGE 3

CS 53/1-23
B