


# PUBLIC LAND CORNERS

Index: 1223

WEYERHAEUSER TIMBER COMPANY  
 SPRINGFIELD BRANCH

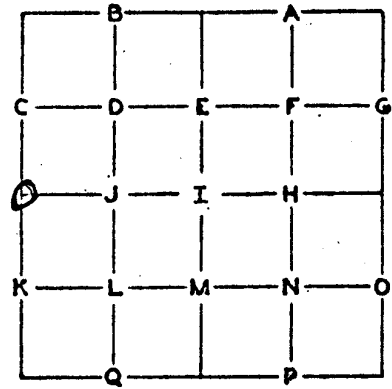

TOWNSHIP 30 S RANGE 4 W

SECTION 36 CORNER NE

COUNTY LANE OREGON

<b>GLO SURVEY RECORD</b> DATE: <u>1854</u>	<b>PRESENT CONDITION - (DESCRIBE FULLY - USE PAGE 2 IF NEEDED FOR EXPLANATION.)</b>
---	---

<b>ACCESSORIES:</b>			
BEARING-	LINKS-	FEET-	
N 33° E	1.0	33.0	As per
N 65° W	.85	54.0	Should have been 1.2 <sup>W</sup> when scribbled. Now it is a red scribble. (Scribbled in the back).

<b>SURVEY RECORD</b> DATE: <u>1854</u>	<b>PRESENT CONDITION:</b>
S 33° E 6.145 19.0'	11.0' E 31'
S 10° E 5.126 15.4'	12.0' E 31'

CORNER SET: 2" Metal Pipe MAGNETIC DECLINATION: 888 20°

BEARING AND DISTANCE TO ABOVE IDENTIFIED SURVEY ACCESSORIES:			
BEARING-	FEET-	SURVEY -	
S 65° W	55	GLO	51.5' E 31'
S 33° E	40.0	Lane Co.	
S 30° W	52.0	Lane Co.	

CS 53/1-108

ACCESSORIES ADDED THIS DATE:

MAGNETIC DECLINATION

122.3  
20°

BEARING	FEET	ORIG. B.T.	"W" NAIL	PLATE	BRASS DISC
N 51° W	24.6	x	x	x	
N 59° E	2.1		x	x	

IDENTIFIED ON PHOTO:

INFORMATION ON LOCATION OF CORNER AS NOW SET:

GROUND COVER: Sisal, fern, bare, rocky ground

(USING FORM LINES SKETCH TOPOG AT CORNER ON PAGE 2 PLAT)

SLOPE FACES (GIVE BEARING IN DEGREES) N 80° E ON MINUS (-) 13%

NORTH: -10% 100'; -10% PROF. ON C-E

FROM CORNER -

SOUTH: +21% Logged to east.

EAST: +15% Logged both sides line

WEST: +3% Scattered old growth and forest.

WORK DONE FOR W. T. CO.:

FIELD NOTES IN BOOK:

BY: \_\_\_\_\_ DATE: \_\_\_\_\_  
ENGINEER - SURVEYOR

ASSISTED BY: Robert Banta

UNDER THE SUPERVISION OF:

COPIES SENT TO: \_\_\_\_\_

SEAL

PAGE 3

CS 53/1-103