


# PUBLIC LAND CORNERS

Index: 1224

WEYERHAEUSER TIMBER COMPANY  
 SPRINGFIELD BRANCH

TOWNSHIP \_\_\_\_\_ RANGE \_\_\_\_\_ W  
 SECTION \_\_\_\_\_ CORNER \_\_\_\_\_ SW  
 COUNTY \_\_\_\_\_ OREGON

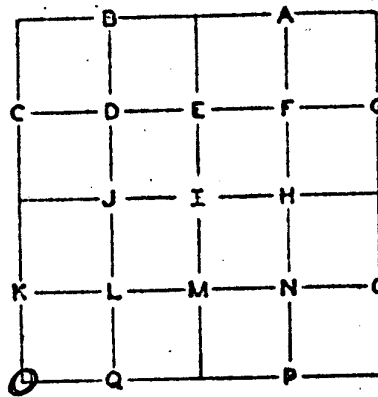

GLO SURVEY RECORD			
CORNER _____		DATE: _____	
ACCESSORIES:			
BEARING-	LINKS-	FEET-	
N 87° E	65	400	20" Stamp
S 23° E	50	300	20" Cedar, 10" face visible
S 75° W	50	300	30" Stamp
N 25° W	30	200	20" Cedar Stamp

PRESENT CONDITION - (DESCRIBE FULLY - USE PAGE 2 IF NEEDED FOR EXPLANATION.)	

SURVEY RECORD	
DATE: _____	
N 57° E 5.0	
N 40° W 28.0	

PRESENT CONDITION:	

CORNER SET: Found 6.4x10" stake MAGNETIC DECLINATION: 200 20°  
 (Set on top & give point and for distance & bearing.)

BEARING AND DISTANCE TO ABOVE IDENTIFIED SURVEY ACCESSORIES:		
BEARING-	FEET-	SURVEY -
N 7° E	20.0	GLO
N 7° E	10.0	GLO
S 7° W	30.0	GLO
S 7° W	50.0	GLO

CS 5311-104  
 A

ACCESSORIES ADDED THIS DATE:

MAGNETIC DECLINATION

20°

	BEARING	FEET	ORIG. B.T.	"W" NAIL	PLATE	BRASS DISC
	N 65° E	5.3	CSBT	X	X	
	S 55° E	13.5		X	X	
30' E - STUMP	S 03° W	31.4		X	X	
	N 44° W	27.8	CSBT	X	X	

IDENTIFIED ON PHOTO:

INFORMATION ON LOCATION OF CORNER AS NOW SET:

GROUND COVER: Forest

(USING FORM LINES SKETCH TOPOG AT CORNER ON PAGE 2 PLAT)

SLOPE FACES (GIVE BEARING IN DEGREES) S 15° W ON MINUS (-) 38 %

NORTH: + 12% (50) timber + 10% (90) open field, logged East, old growth to west.

SOUTH: - 21% timbered to east, open field to west.

EAST: + 16% logged to north, timbered to south.

WEST: + 21% timbered to north, open field to south.

FROM CORNER -

WORK DONE FOR W. T. CO.:

FIELD NOTES IN BOOK:

BY: ENGINEER - SURVEYOR

DATE: 2.12.58

ASSISTED BY: Robert Danta

UNDER THE SUPERVISION OF:

COPIES SENT TO:

SEAL

PAGE 3

CS 53/1-104  
B