RENEW WEST 1/4 S7 T30S R5W

FOUND — 2" I.PIPE, 24" UNDER
NEITHER BT STANDING. WE
DO FIND ROOTS OF NE BT.

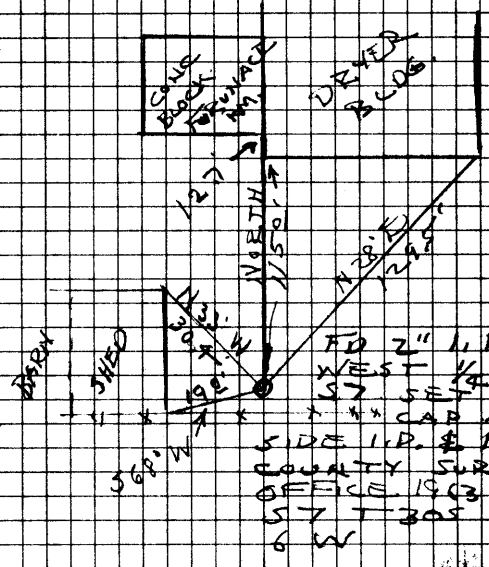

NOTE — BRASS CAP SET FLUSH.

OCT. 21 — 1963

J.B.
M.D.
J.H.

DIETZGEN NO. 385-6

C. S. File No. 53/26