SPRINGFIELD SURVEY FILE

PUBLIC LAND CORNERS

WEYERHAEUSER COMPANY
SPRINGFIELD BRANCH

TOWNSHIP 20 S RANGE 6 W

SECTION 22 CORNER SW

COUNTY Lane & Douglas OREGON

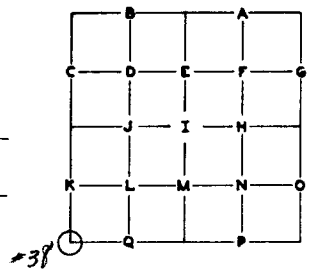

MAGNETIC DECLINATION 20°

ACCESSORIES ADDED THIS DATE:

	BEARING	FEET	ORIG. B.T.	"W" NAIL	PLATE	BRASS DISC
32" fir	N 49° E	33.4	GLO 1950	X	X	--
16" fir	S 72° E	23.4	"	X	X	--
44" fir stump	S 52° W	77.3	"	X	X	--
48" fir	N 30° W	76.3	--	X	X	

IDENTIFIED ON PHOTO:

GLO SURVEY RECORD

CORNER Brass Cap DATE: 1950 Resurvey

ACCESSORIES:

	BEARING-	LINKS-	FEET-
13" fir	N 48° E	39	25.7
42" fir	S 86½°E	120	79.2
60" fir	S 53° W	119	78.5
24" fir	N 30° 45'W	53	35.0

Probably 1950 GLO SURVEY RECORD DATE:

16" Fir S 72° E 23.4' from corner

PRESENT CONDITION - (DESCRIBE FULLY - USE PAGE 2 IF NEEDED FOR EXPLANATION.)

Iron Post apparently in place as set by GLO, but is setting at an angle (from vertical) in side cut of road. Considerable erosion of dirt from around post.

Good condition but is 32" fir
No tree of this description found.
Now stump; cut in logging; good scribing
Apparently removed in road construction

PRESENT CONDITION:

Not in GLO 1950 notes

CORNER ~~SET~~ Used apparent location of brass cap MAG. DECL.: 20°

BEARING AND DISTANCE TO ABOVE IDENTIFIED SURVEY ACCESSORIES:

BEARING-	FEET-	SURVEY-	
N 49° E	33.4	1950	measured to face 32" Fir
S 72° E	23.4		16" Fir
S 52° W	77.3	1950	Fir stump

INFORMATION ON LOCATION OF CORNER AS NOW SET:

GROUND COVER: Salal

(USING FORM LINES SKETCH TOPOG AT CORNER ON PAGE 2 PLAT)

SLOPE FACES (GIVE BEARING IN DEGREES) West ON MINUS (-) 76 %

FROM CORNER TO:

NORTH: - 13%; East of line logged 8-10 yrs ago; uncut Old Growth fir to West of line

SOUTH: + 33%; West of line logged 6 to 8 yrs ago; uncut large 2nd Growth fir to East

EAST: + 76%

WEST: - 76%

WORK DONE FOR W. CO.

FIELD NOTES IN BOOK:

BY: Francis L. Fick DATE: 6/20/61
~~ENGINEER SURVEYOR~~
Land Agent

ASSISTED BY:

COPIES SENT TO:

UNDER THE SUPERVISION OF:

SEAL

CS53/102-3