


PUBLIC LAND CORNERS

WEYERHAEUSER TIMBER COMPANY
 SPRINGFIELD BRANCH

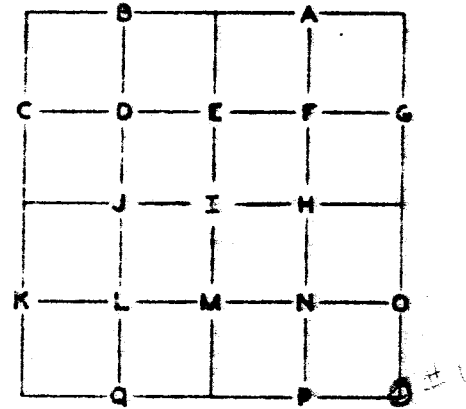

TOWNSHIP _____ RANGE _____ W

SECTION _____ CORNER _____ E

COUNTY _____ OREGON

GLO SURVEY RECORD

DATE: _____

CORNER _____

PRESENT CONDITION - (DESCRIBE FULLY -
 USE PAGE 2 IF NEEDED FOR EXPLANATION.)

ACCESSORIES:

	BEARING-	LINKS-	FEET-
60°			
36°			
36°			
185°			

SURVEY RECORD

DATE: _____

PRESENT CONDITION: _____

CORNER SET: _____

MAGNETIC DECLINATION: _____

BEARING AND DISTANCE TO ABOVE IDENTIFIED SURVEY ACCESSORIES:

BEARING-	FEET-	SURVEY -
36° E	1.9	U.S. O-10
150° E	0.13	" "
30° W	0.13	" "
10° W		" "

60° E-10 A.T.

60° " "

16° " "

CS 53/106-9

N

