


PUBLIC LAND CORNERS

LVOC 3

WEYERHAEUSER TIMBER COMPANY
 SPRINGFIELD BRANCH

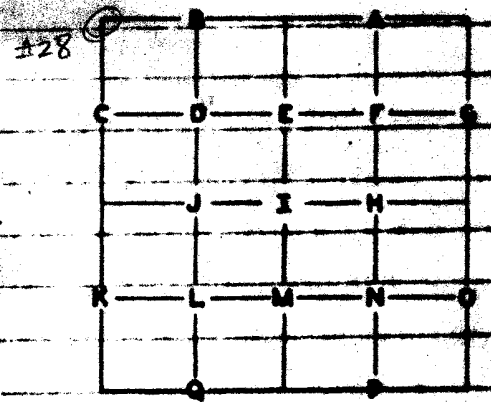

TOWNSHIP 23 S RANGE 3 W
 SECTION 28 CORNER NW
 COUNTY LAKE DOUGLAS LINE OREGON

GLO SURVEY RECORD

PRESENT CONDITION - (DESCRIBE FULLY - USE PAGE 2 IF NEEDED FOR EXPLANATION)

DATE: 1888
 CORNER Post

Method WEYERHAEUSER
RELEASED CORNER

ACCESSORIES:

	BEARING-	LINKS-	FEET-	
15" Cedar	N 50° W	45	29.7	26" x 15' stub, badly burned, no scribing
8" Cedar	S 68° W	37	24.4	38" Cedar, faces not chopped
12" Cedar	S 55° E	12	7.9	86" Fir, bark scribing visible
86" Fir	N 50° E	19	12.5	

SURVEY RECORD

PRESENT CONDITION:

CORNER SET: By dist & bearing from NW and SE MAG. DECL: 20°
 GLO Mt's

BEARING AND DISTANCE TO ABOVE IDENTIFIED SURVEY ACCESSORIES:

BEARING-	FEET-	SURVEY-	
N 50° W	29.7	GLO	Cedar Stub
S 55° E	7.9	GLO	38" Cedar
N 50° E	12.0	GLO	86" Fir

CS 53/107-19

ACCESSORIES ADDED THIS DATE:

MAGNETIC DECLINATION 20°

	BEARING	FEET	ORIG. B.T.	"W" NAIL	PLATE	BRASS DISC
52" Fir Stake	N 5° E	31.0		X	X	
96" Fir	N 61° E	12.0		X	X	
38" Cedar	N 54° E	6.6		X	X	
12" Cedar	S 51° W	32.0		X	X	

IDENTIFIED ON PHOTO:

INFORMATION ON LOCATION OF CORNER AS NOW SET:

GROUND COVER: Swamp forest & Oregon Grape. Old blowdown.

(USING FORM LINES SKETCH TOPOG AT CORNER ON PAGE 2 PLAT)

SLOPE FACES (GIVE BEARING IN DEGREES) N 25° W ON MINUS (-) 32 %

NORTH:

SOUTH:

EAST:

WEST:

FROM CORNER -

AND BEARING FROM THE M. W. V. TO THE CORNER PLUMBED
 WITH DISTANCE
 ON
 REGISTRATION TABLE
 + 10% 135' stream C N 54° W. 529' to Summit Calapooya Mtns. Logged to North
 Old Growth to South
 - 8% Logged to North. Old Growth to South.

WORK DONE FOR W. T. CO.:

FIELD NOTES IN BOOK:

BY: McCheaney
 ENGINEER - SURVEYOR

DATE: April 1, 1938

UNDER THE SUPERVISION OF:

ASSISTED BY:

COPIES SENT TO:

SEAL

PAGE 3