PUBLIC LAND CORNERS

WEYERHAEUSER TIMBER COMPANY
SPRINGFIELD BRANCH

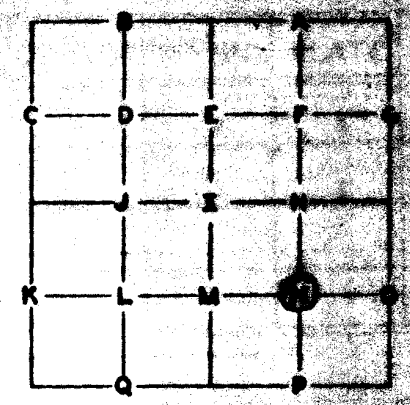

TOWNSHIP 24 S RANGE 2 W

SECTION 28 CORNER N SE 1/16

COUNTY DOUGLAS OREGON

GLO SURVEY RECORD

DATE:

CORNER

ACCESSORIES:

	BEARING-	LINKS-	FEET-

PRESENT CONDITION - (DESCRIBE FULLY - USE PAGE 2 IF NEEDED FOR EXPLANATION.)

V. HOSFORD

SURVEY RECORD

DATE: 19[illegible]

4" HEMLOCK POST		
10" HEMLOCK	N 32½° E	27.8'
10" CEDAR	E	[illegible]

PRESENT CONDITION:

PIPE [illegible]

GOOD [illegible]

GOOD [illegible]

CORNER SET: PIPE [illegible]

MAGNETIC DECLINATION: 20°

BEARING AND DISTANCE TO ABOVE IDENTIFIED SURVEY ACCESSORIES:

BEARING-	FEET-
N 33° E	[illegible]
S 89° E	[illegible]

CS 53/110-8

PAGE 1

ACCESSORIES ADDED THIS DATE:

	BEARING-	FEET	ORIG. BT	W²-NAIL	PLATE	BRASS DISC
10" CEDAR	S 89° E	30.8		X	X	
32" FIR	W 77° W	21.3		X	X	

IDENTIFIED ON PHOTO:

INFORMATION ON LOCATION OF CORNER AS NOW SET:

DESCRIPTION OF GROUND COVER AND GROUND SLOPE AT CORNER: PIPE IS IN [illegible] [illegible] EAST EDGE OAT FIRE TRAIL

FROM CORNER NORTH: [illegible] GREEN OG TO WEST AND TO EAST

SOUTH: [illegible] 60[illegible] [illegible] 150', [illegible] [illegible] IS GREEN FORKS. GREEN [illegible] EAST

EAST: LEVEL

WEST: [illegible] 2% OG

WORK DONE FOR W. T. CO.

BY: Glen McChesney
ENGINEER - SURVEYOR

DATE: OCTOBER 2[illegible], 195[illegible]

ASSISTED BY:

UNDER SUPERVISION OF:

COPIES SENT TO:

SEAL