


PUBLIC LAND CORNERS

WEYERHAEUSER TIMBER COMPANY
 SPRINGFIELD BRANCH

TOWNSHIP 24 S RANGE _____

SECTION 28 CORNER S E

COUNTY Douglas OREGON

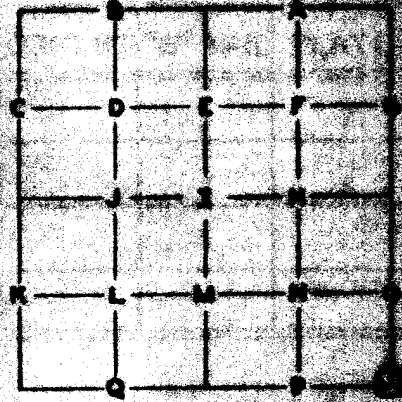

GLO SURVEY RECORD

DATE: 1894

CORNER _____

PRESENT CONDITION - (DESCRIBE FULLY -
 USE PAGE 2 IF NEEDED FOR EXPLANATION)

ACCESSORIES:

	BEARING-	LINKS-	FEET-	
10" CHAIN	N 37° E	20	13.1	10" CHAIN - LEANS TO S W
6" HINGELOCK	S 28° E	14	9.2	6" HINGELOCK - REMAINS VISIBLE - GREEN
8" HINGELOCK	S 15° W	17	11.1	8" HINGELOCK - REMAINS VISIBLE - GREEN
8" HINGELOCK	N 40° W	14	9.2	8" HINGELOCK - SCAL - NOT CHIPPED GREEN

SURVEY RECORD

DATE: _____

PRESENT CONDITION: _____

CORNER SET: FRASS CAP GLO MAGNETIC DECLINATION: 20°

BEARING AND DISTANCE TO ABOVE IDENTIFIED SURVEY ACCESSORIES:

BEARING-	FEET-	
N 33° E	10.0	10" CHAIN - LEANS TO S W
S 27° E	8.0	6" HINGELOCK
S 15° W	10.5	8" HINGELOCK
N 61° W	8.0	8" HINGELOCK
S 38° W	8.0	8" HINGELOCK - SCRIPT 19
N 11° E	5.0	8" HINGELOCK - SCRIPT 19

C.S. 53/110-9

ACCESSORIES ADDED THIS DATE:

	BEARING-	FEET	ORIG. BT	W ² -NAIL	PLATE	BRAS: DISC
56" FLE STUMP	N 47° E	18.5		X	X	
28" SUGAR PINE	S 43° E	10.0		X	X	
18" HEMLOCK	S 37° W	11.5		X	X	
14" HEMLOCK	N 57° W	8.6	X	X	X	

IDENTIFIED ON PHOTO:

INFORMATION ON LOCATION OF CORNER AS NOW SET:

DESCRIPTION OF GROUND COVER AND GROUND SLOPE AT CORNER: 13000

FROM CORNER NORTH: 90° 100' CREEK FLOWS SE. EDGE OF NE SE. RESIDUAL TREES

BEING LOGGED TO WEST OF TREE

SOUTH: 100' 50' TREE LOGGED TO EAST OF WEST

EAST: 157' 50' 100'

WEST: 157' 50' TO SOUTH, LOGGED TO SOUTH WITH NO CLOSE TO LINE

WORK DONE FOR W. T. CO.

BY: *Allen Mc Cheney*
ENGINEER - SURVEYOR

DATE: OCTOBER 24, 1957

ASSISTED BY: _____

UNDER SUPERVISION OF:

COPIES SENT TO: _____

SEAL