


PUBLIC LAND CORNERS

WEYERHAEUSER TIMBER COMPANY
 SPRINGFIELD BRANCH

TOWNSHIP 24 S RANGE 2 E
 SECTION 21 CORNER SE
 COUNTY DOUGLAS OREGON

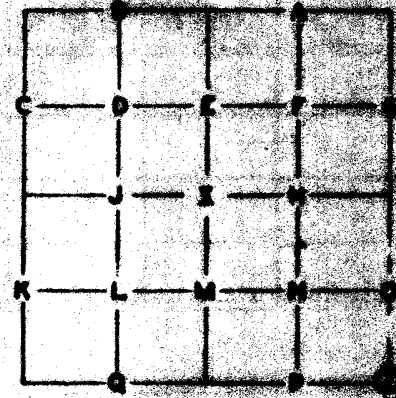

GLO SURVEY RECORD

PRESENT CONDITION - (DESCRIBE FULLY -
 USE PAGE 2 IF NEEDED FOR EXPLANATION.)

DATE: _____
 CORNER _____

ACCESSORIES:

	BEARING-	LINKS-1	FEET-	
24" HEMLOCK	N 84° E	62	40.9	REMAINS STUMP - ROTTED - NO SCRIPING
24" CEDAR	S 20° E	25	16.5	OK - GREEN - SCRIPING VISIBLE
5" CEDAR	S 66½° W	31	20.5	OK - GREEN - SCRIPING VISIBLE
60" FIR	N 35° W	33	21.8	OK - GREEN - SCRIPING VISIBLE

W.T.Co. SURVEY RECORD

PRESENT CONDITION:

DATE: JULY 21, 1954

1" METAL PIPE				UNDER 36" FIR WINDFALL
54" FIR	N 30° W		19.5'	OK - ORIGINAL BT
36" FIR	N 40° E		41.5'	NOW A STUMP (TREE FELLED)
28" CEDAR	S 26° E		12.8'	OK - ORIGINAL BT
8" CEDAR-	S 66° W		18.5'	OK ORIGINAL BT

CORNER SET: _____ MAGNETIC DECLINATION: _____

BEARING AND DISTANCE TO ABOVE IDENTIFIED SURVEY ACCESSORIES:

BEARING-	FEET-	

53/110-11

ACCESSORIES ADDED THIS DATE:

	BEARING-	FEET	ORIG. BT	W ² -NAIL	PLATE	BRASS DISC

IDENTIFIED ON PHOTO:

INFORMATION ON LOCATION OF CORNER AS NOW SET:

DESCRIPTION OF GROUND COVER AND GROUND SLOPE AT CORNER: SALAL

FROM CORNER NORTH: - 42% 300' PIPE W R'D.A.E } See letter dated 7/26/59

SOUTH: + 46% for 40' then + 28% to top ridge

EAST: ADJACENT TO NORTH & SOUTH

WEST: GREEN TIMBER

WORK DONE FOR W. T. CO.

BY: Glen McChesney ENGINEER - SURVEYOR DATE: OCTOBER 23 1957

ASSISTED BY: _____

UNDER SUPERVISION OF:

COPIES SENT TO: _____



WEYERHAEUSER TIMBER COMPANY

Growing Trees and Manufacturing Forest Products

SPRINGFIELD LUMBER DIVISION • SPRINGFIELD, OREGON

July 26, 1958

Douglas County Surveyor
Roseburg, Oregon

Dear Sir:

On October 23, we made a section corner reference report of the SE corner of Section 21, Township 24 South, Range 2 West.

We have had an error called to our attention, and we ask that your copy be changed on Page 3 to read:

From Corner North - -42%
South - ~~+46%~~ for 40' then ~~+28%~~
to top ridge
East - Logged to North and South
West - Green Timber

Respectfully,

WEYERHAEUSER TIMBER COMPANY
Springfield Lumber Division

Lester E. Calder
Land Supervisor

LEC:lh

FILED
RECEIVED

JUL 23 1958

Douglas County Surveyor
Douglas County, Ore.