


PUBLIC LAND CORNERS

WEYERHAEUSER COMPANY
 SPRINGFIELD BRANCH

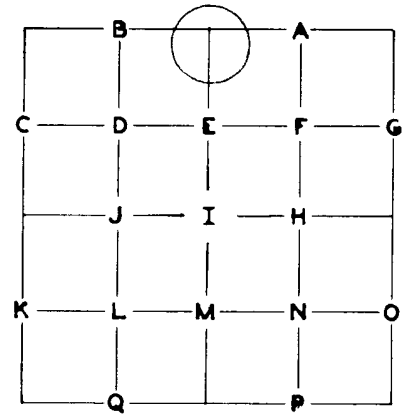

TOWNSHIP 24S RANGE 2-W
 SECTION 9 CORNER N $\frac{1}{2}$
 COUNTY Douglas OREGON


GLO SURVEY RECORD DATE: <u>1894</u> CORNER <u>18 x 12 x 8 Stone</u>	PRESENT CONDITION - (DESCRIBE FULLY - USE PAGE 2 IF NEEDED FOR EXPLANATION.) Found stone in place																								
ACCESSORIES:																									
<table border="1" style="width:100%; border-collapse: collapse;"> <thead> <tr> <th style="width:15%;">BEARING-</th> <th style="width:15%;">LINKS-</th> <th style="width:15%;">FEET-</th> <th style="width:55%;"></th> </tr> </thead> <tbody> <tr> <td>40" Fir</td> <td>N50W</td> <td>29</td> <td>19.1</td> </tr> <tr> <td>36" Fir</td> <td>S27E</td> <td>52</td> <td>34.3</td> </tr> <tr> <td> </td> <td> </td> <td> </td> <td> </td> </tr> </tbody> </table>	BEARING-	LINKS-	FEET-		40" Fir	N50W	29	19.1	36" Fir	S27E	52	34.3													44" Fir - face overgrown 40" Fir - Chopped away overgrowth and found scribe marks.
BEARING-	LINKS-	FEET-																							
40" Fir	N50W	29	19.1																						
36" Fir	S27E	52	34.3																						
SURVEY RECORD DATE: _____	PRESENT CONDITION: _____																								

CORNER ~~36x~~ Stone in original position MAG. DECL.: 20

BEARING AND DISTANCE TO ABOVE IDENTIFIED SURVEY ACCESSORIES:


BEARING-	FEET-	SURVEY -	
N47W	20.7	GLO	Center of tree measurement
S27E	34.3	GLO	" " "

SECTION 9 TOWNSHIP 24S RANGE 2W

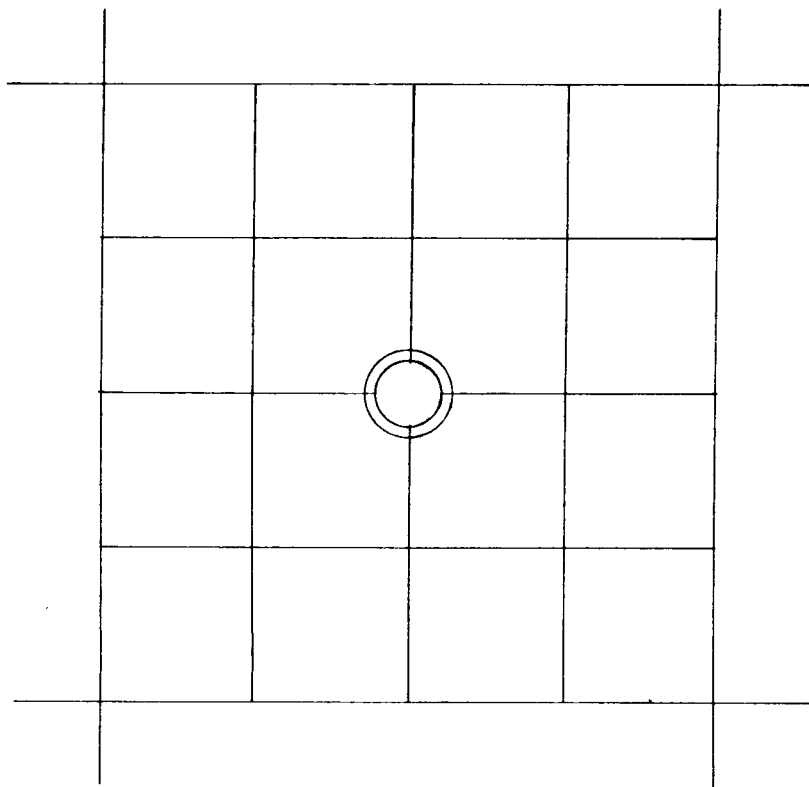

 LINE MARKED BY NOTCH CUT IN BLAZE.

 KNOWN CORNER.

 REFERENCED CORNER
BY WEYERHAEUSER
METHOD.

ACCESSORIES ADDED THIS DATE:

MAGNETIC DECLINATION 20°

	BEARING	FEET	ORIG. B.T.	"W" NAIL	PLATE	BRASS DISC
40" Fir	S20E	32.1	X	X	X	-
44" Fir	N43W	22.6	X	X	X	-

IDENTIFIED ON PHOTO:

INFORMATION ON LOCATION OF CORNER AS NOW SET:

GROUND COVER: Rhodendron

(USING FORM LINES SKETCH TOPOG AT CORNER ON PAGE 2 PLAT)

SLOPE FACES (GIVE BEARING IN DEGREES) East ON MINUS (-) -40% %

NORTH: +50% 100' to rock bluff,

FROM CORNER |

SOUTH: - 7%

EAST: - 25% top end of bluff then steeper

WEST: + 60% 400' to ridge top

WORK DONE FOR W. CO. _____

FIELD NOTES IN BOOK: _____

BY: D. L. Ellis DATE: 6/10/70

~~ENGINEER - SUPERVISOR~~

ASSISTED BY: L. B. Wilson

UNDER THE SUPERVISION OF:

COPIES SENT TO: _____

SEAL

53/110