


# PUBLIC LAND CORNERS

WEYERHAEUSER COMPANY  
SPRINGFIELD BRANCH

TOWNSHIP 24S RANGE 3W  
SECTION 1 CORNER NW  
COUNTY Douglas OREGON

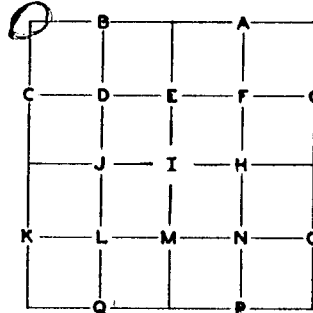

GLO SURVEY RECORD	PRESENT CONDITION - (DESCRIBE FULLY - USE PAGE 2 IF NEEDED FOR EXPLANATION.)																								
DATE: <u>1882</u>																									
CORNER <u>10" Hemlock</u>	<u>24" wind thrown stump with faces gone</u>																								
ACCESSORIES:																									
<table border="1" style="width: 100%; border-collapse: collapse;"> <thead> <tr> <th style="width: 15%;">BEARING-</th> <th style="width: 15%;">LINKS-</th> <th style="width: 15%;">FEET-</th> <th style="width: 55%;"></th> </tr> </thead> <tbody> <tr> <td><u>6" Hem</u></td> <td><u>N60W</u></td> <td><u>14</u></td> <td><u>9.2</u></td> <td><u>No evidence</u></td> </tr> <tr> <td><u>6" Hem</u></td> <td><u>N30E</u></td> <td><u>39</u></td> <td><u>25.7</u></td> <td><u>No evidence</u></td> </tr> <tr> <td><u>24" Ced.</u></td> <td><u>S01E</u></td> <td><u>32</u></td> <td><u>21.1</u></td> <td><u>Splintered by logging - faces gone</u></td> </tr> <tr> <td><u>20" Ced.</u></td> <td><u>S70W</u></td> <td><u>49</u></td> <td><u>32.3</u></td> <td><u>No evidence</u></td> </tr>
SURVEY RECORD	PRESENT CONDITION:																								
DATE:																									

CORNER SET: W-nail in corner tree guarded by a 2x2 cedar post. MAG. DECL.: 20°E

BEARING AND DISTANCE TO ABOVE IDENTIFIED SURVEY ACCESSORIES:

BEARING-	FEET-	SURVEY -

FILED  
PAGE 1  
RECEIVED

OCT 19 1965

COUNTY SURVEYOR  
DOUGLAS COUNTY, ORE.

SEE 1964 NOTES  
ATTACHED.

C. S. File No. 53/111-27

26  
29  
29  
25  
22  
23

ACCESSORIES ADDED THIS DATE:

MAGNETIC DECLINATION 20°E

	BEARING	FEET	ORIG. B.T.	"W" NAIL	PLATE	BRASS DISC
11" Hambok stump	S 79° 45' W	18.1	—	X	X	—
30" Cedar stump	S 77° 15' W	25.8	X	X	X	—
24" Cedar stump	N 56° E	53.7	—	X	X	—
30" Cedar stump	N 05° E	41.2	—	X	X	—
23" Cedar stump	N 61° 30' W	82.2	—	X	X	—

IDENTIFIED ON PHOTO:

INFORMATION ON LOCATION OF CORNER AS NOW SET:

GROUND COVER: 1965 Hi-lead logging

(USING FORM LINES SKETCH TOPOG AT CORNER ON PAGE 2 PLAT)

SLOPE FACES (GIVE BEARING IN DEGREES) S 30° E ON MINUS (-) 20 %

NORTH: +25%

FROM CORNER — SOUTH: -20% 30' to E of CG 100 Road

EAST: +25%

WEST: -10%

WORK DONE FOR W. CO.

FIELD NOTES IN BOOK:

BY: Bruce W. Wood DATE: 3-23-65  
ENGINEER - SURVEYOR

ASSISTED BY: Robert Quick  
William Kirk

COPIES SENT TO:

UNDER THE SUPERVISION OF:

FILED  
RECEIVED

OCT 19 1965

SEAL  
COUNTY SURVEYOR  
PAGE 3  
DOUGLAS COUNTY, ORE.