


PUBLIC LAND CORNERS

WEYERHAEUSER TIMBER COMPANY
 SPRINGFIELD BRANCH

TOWNSHIP 24 S RANGE 3
 SECTION 17 CORNER E 1/4
 COUNTY DOUGLAS OREGON

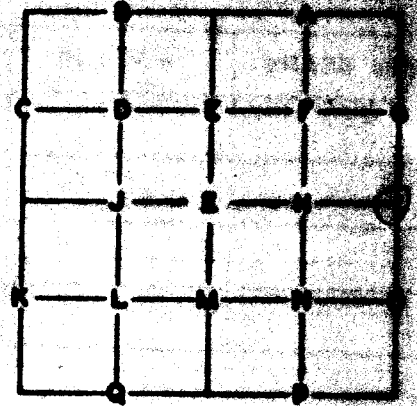

SUTHERLIN FIELD BOOK NO. 67

RESERVE GLO SURVEY RECORD

DATE: 1950
 CORNER BRASS CAP

PRESENT CONDITION - (DESCRIBE FULLY)

OK

ACCESSORIES:

	BEARING-	LINKS-	FEET-
18" FIR	N 6° E	121	
22" FIR	N 13° W	283	

WINDFALL

WIND SURVEY RECORD

DATE: 1953
 30" FIR STUMP S 45° W 93.1'
 44" FIR STUMP N 42° W 89.4'

PRESENT CONDITION:

PLATES AND "W" NAILS OK

PLATES AND "W" NAILS OK

CORNER SET: _____ MAGNETIC DECLINATION: _____

BEARING AND DISTANCE TO ABOVE IDENTIFIED SURVEY ACCESSORIES:

BEARING-	FEET-	
S 45° W	93.1	30" FIR STUMP WITH WIND PLATES AND "W" NAILS
N 42° W	89.4	44" FIR STUMP WITH WIND PLATES AND "W" NAILS
N 13° W	283.8	22" FIR

ACCESSORIES ADDED THIS DATE:

8700

	BEARING -	FEET -	"W" NAIL -	PLATE -	BRASS DISC -

IDENTIFIED ON PHOTO:

INFORMATION ON LOCATION OF CORNER AS NOW SET:

DESCRIPTION OF GROUND COVER AND GROUND SLOPE AT CORNER: _____

FROM CORNER NORTH: _____

SOUTH: _____

EAST: _____

WEST: _____

WORK DONE FOR W. T. CO.

BY: Hale
ENGINEER - SURVEYOR

DATE: JANUARY 1956

ASSISTED BY: RICHARD WAFER

UNDER SUPERVISION OF:

COPIES SENT TO: _____