


WEYERHAEUSER TIMBER COMPANY
 SPRINGFIELD BRANCH

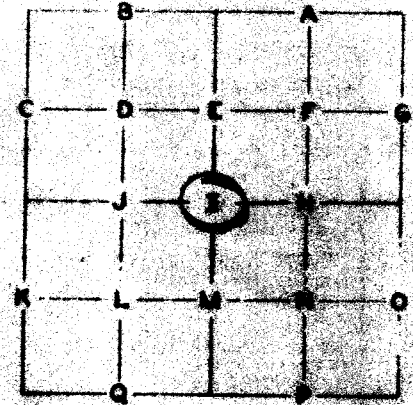

TOWNSHIP 26 S RANGE W
 SECTION 12 CORNER T
 COUNTY DOUGLAS OREGON

GLO SURVEY RECORD

CORNER _____ DATE: _____

PRESENT CONDITION - (DESCRIBE FULLY
 USE PAGE 2 IF NEEDED FOR EXPLANATION)

ACCESSORIES:

BEARING-	LINKS-	FEET-

W.T.Co. SURVEY RECORD
 DATE: SEPTEMBER, 1946

PRESENT CONDITION:

POST

30" FIB	S 28° E	13.0'
21" CHISEL	N 1° W	2.2'

- PLATE - NO "V" NAIL

- PLATE - NO "V" NAIL

REFERENCE - SEE PAGE 3

CORNER SET: _____

MAGNETIC DECLINATION: _____

BEARING AND DISTANCE TO ABOVE IDENTIFIED SURVEY ACCESSORIES:

BEARING-	FEET-

CS 53/15-20

ACCESSORIES ADDED THIS DATE

	BEARING -	FEET	ORIG. BT	"W" - NAIL	PLATE

IDENTIFIED ON PHOTO:

INFORMATION ON LOCATION OF CORNER AS NOW SET:

DESCRIPTION OF GROUND COVER AND GROUND SLOPE AT CORNER: _____

FROM CORNER NORTH: _____

SOUTH: _____

EAST: _____

WEST: _____

BY: *Al C. Chesney* WORK DONE FOR W. T. CO.
 ENGINEER - SURVEYOR

DATE: _____

ASSISTED BY: _____

UNDER SUPERVISION OF: _____

COPIES SENT TO: _____