

Renewal 32/33 T26
5/4 T27S R7W

Found:

Orig 36" D. Fir	Now snag	N 85° E	117
Stumps	scar	(Burnt)	
Orig 39" D. Fir	Now snag	N 69° W	297
Stumps	scar	(Burnt)	
28" D. Fir	Now snag	S 68 1/2° W	792
Stumps	scar		
36" D. Fir	Now stump	East	51 1/2


Also Brass cap set flush with ground M.K.P.

B.L.M.
 T26S R7W
 532 / 533
 55 / 54
 T27S
 1909

DIETZEN NO. 385-6

Renewal

Set 5/8" I Rods for bearing objects as follows:

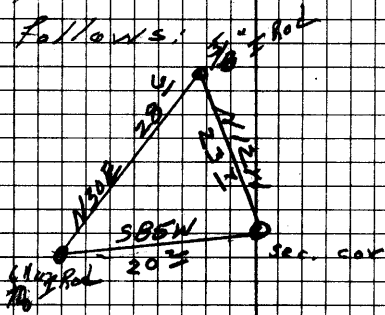

1-16-20

J.M.C.
 F.M.G.
 M.S.P.

T26 #85
 T27-#163

O.K.
 D.O.P.

C.S. File No. 54/23-19