

Review  $\frac{1}{4}$  <sup>S.14</sup> 523 T255 R3W

Fd. G.L.D. BRASS Cap MKd."  $\frac{1}{4}$  <sup>S.14</sup> 523 1943"

\$ 1943 B.T.'s as follows -

36" Hemlock N.  $56\frac{1}{2}^{\circ}$  E, 33<sup>2</sup> ft.

Recorded as 26" Dia. - Now SNAG APPROX.

50 ft high - Face Badly Burned.

No scribe fd.

42" Now 42" FIR S.  $79^{\circ}$  W, 207<sup>2</sup> ft.

Now shattered SNAG 15 ft. high -

Fragmentary scribe visible on Burned.

face - MK. New B.T.'s -

7" D. FIR N.  $6^{\circ}$  W, 6<sup>5</sup> ft.

Mkd."  $\frac{1}{4}$  S 14 CS BT"

9" D. FIR S,  $20\frac{1}{2}^{\circ}$  W, 53<sup>1</sup> ft.


Mkd."  $\frac{1}{4}$  S 23 CS BT"

also a steel fence post has been  
place along side BRASS cap.

June 24, 1966

J.R.T.  
J.H.

FILED  
RECEIVED

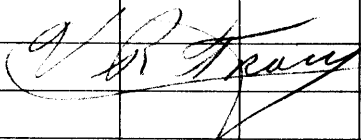

JUN 24 1966

COUNTY SURVEYOR  
DOUGLAS COUNTY, ORE.  
C554/27-5

\* #62  
O.K. J.W.B.