

10" Fir N.31°15'E. 20.0  
10" Fir S.21°25'E. 15.6  
1" I.P. Set 1946

1326.4

S.89°45'W. 2652.8

14" Madrona N.47°45'W. 4.1  
10" Fir S.20°E. 22.8  
1/2" I.P. 1/4 Cor.

1326.4

56" Fir N.28°E. 42.6  
28" Fir S.84°E. 42.1  
FOUND 5/8" I. Rod Set by Shaner 1965

1/2" I.P.

300

3/4" I.P.

423.0


3/4" I.P.

603.4

FILED  
RECEIVED

NOV 9 1968

COUNTY SURVEYOR  
DOUGLAS COUNTY, ORE.

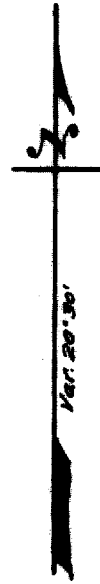

CORNER'S SET LINE NOT RUN

13.20 Ac.

18.70 Ac.

N.1°28'E. 1349.4

N.1°28'E. 1351.3

N.2°E. 1349.5  
(19546 Shaner Survey)

COUNTY SURVEYOR'S FILE DATA  
DID NOT REMOVE FROM OFFICE

30" Fir Stump S.14°45'E. 46.8  
36" Fir S.47°15'W. 114.0  
Brass Cap 1/4 Cor. between Secs. 5 & 6

1314.4

S.89°10'E. 2628.4  
1/4 Cor. 1" Axle  
18" Madrona N.2°18'W. 38.1  
12" Madrona N.85°10'W. 42.6

300

1" Axle

423.0

3/4" I.P.

591.4

1.51 Ac.

Center Section 5  
FOUND 5/8" I. Rod Set by Shaner 1965  
12" Fir S.17°W. 23.7  
16" Fir N.49°W. 74.3

3/4" I.P.

123.8

3/4" I.P.

1450.76

199.5

525.267

51.282

102.5

3/4" I.P.

3/4" I.P.

3/4" I.P.

3/4" I.P.

3/4" I.P.

199.5

102.5

199.5

102.5

COUNTY SURVEYOR'S OFFICE  
DOUGLAS COUNTY, OREGON.

SURVEY FOR

LEONARD SELL IN SECTION 5

TOWNSHIP 32 SOUTH, RANGE 4 WEST, W.M.

GEO. J. WENDEROTH, DEPUTY. Nov. 5, 1966

SCALE 1" = 200 ft.

REGISTERED  
OREGON