


Fd. O.K. 27-2

N. $\frac{1}{4}$ 510

see Rev. # 51,
& Illustration
Below -

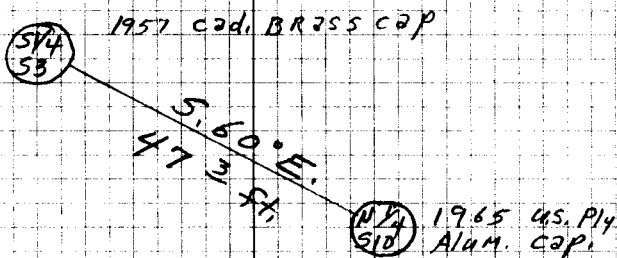

DIETZGEN NO. 385-B

CS 54/40-148

O.K.
J.W.M.